

KANSAS WELL SCHEDULE

Card 1

3 miles, Linwood

Record by Klein Smith Date: 4-27-73 Project: Top-KC State: Kan County: Leav 52

Latitude: _____ Longitude: _____ Accuracy: _____ Owner's well no: _____

Location: _____ SWNE no. sec. 22, T. 12 N., R. 22 E. Well number: 1222E22ACOwner: C E Spring name address RT#1 Linwood (Leav)Owner: C E SPRING 15 16 17 18 19 20 21 22 23 24 25 26 27 28 29 30 31 32 33 34 35 36 37 38 Altitude: _____ Accuracy _____Driller: Hand name address Date drilled: _____Topography, well site: (D) Draw, (F) flood plain, (L) lowland, (R) rolling, (S) slope, (T) terrace, (U) upland L Spring; or depth of well: 30 feet 30 accuracy 3

Diameter: _____ inches or feet 51 52 Depth cased: _____ feet 53 54 55 Spring, or Csg. type: _____ Finish: _____ Lift & power: _____ 5

Pump setting: _____ feet 59 60 61 Use of well: Domestic stock, irrigation, industrial, public supply, observation, none, test _____ 1Water level: _____ above lsd _____ below lsd D73 Water level records avail. _____ 70Description MP: Hand pump with electric motor above lsd _____ below lsd _____

Yield: _____ gpm 71 72 73 74 accuracy 75 Pumping period: _____ hours or days 76 77 Specific capacity: _____ gpm/ft. dd 78 79

Pumpage and other data available: _____ 80

Card 2

Coefficient trans: _____ gpd/ft 15 16 17 Coefficient storage: _____ 18 19 20 Coefficient perm.: _____ gpd/ft²

Aquifer, system or series _____ 21 _____ 22 _____ 23 _____ 24

Aquifer, units _____ 25 26 27 _____ 28 29 30 _____ 31 32 33

Aquifer, thickness: _____ feet 34 35 36 _____ 37 38 39 _____ 40 41 42 _____ 43 44 45

Aquifer, length of well open to: _____ feet 46 47 48 _____ 49 50 51 _____ 52 53 54 _____ 55 56

Bedrock, system: _____ 57 _____ 58 59 60 _____ 61 62 63

Surficial material: _____ lithology _____ infiltration characteristics _____ Log data avail: _____ 64

Quality of water data available: _____ 65 _____ 66 67 _____ 68 69 70

Coefficient of leakage: _____


THE FOLLOWING DATA ARE USED ON THE NATIONAL WELL SCHEDULE
Ownership category: (C) County, (F) Federal Gov't., (M) City, (N) Corp. or Co., (P) Private, (S) State Agency, (W) Water Dist. P 71Method drilled: (A) Air, (B) bored, (C) cable, (D) dug, (H) driven, (I) hyd. rotary, (J) jetted, (R) rev. rotary, (T) trenching, (S) spring, D 72

Physiographic province: _____ 73 74 Section: _____

Drainage basin: _____ 75 76 Subbasin: _____ Depth to basement: _____ 77 78 79 source of data (basement) _____ 80

Quadrangle

Well no. 12-22E-22AC

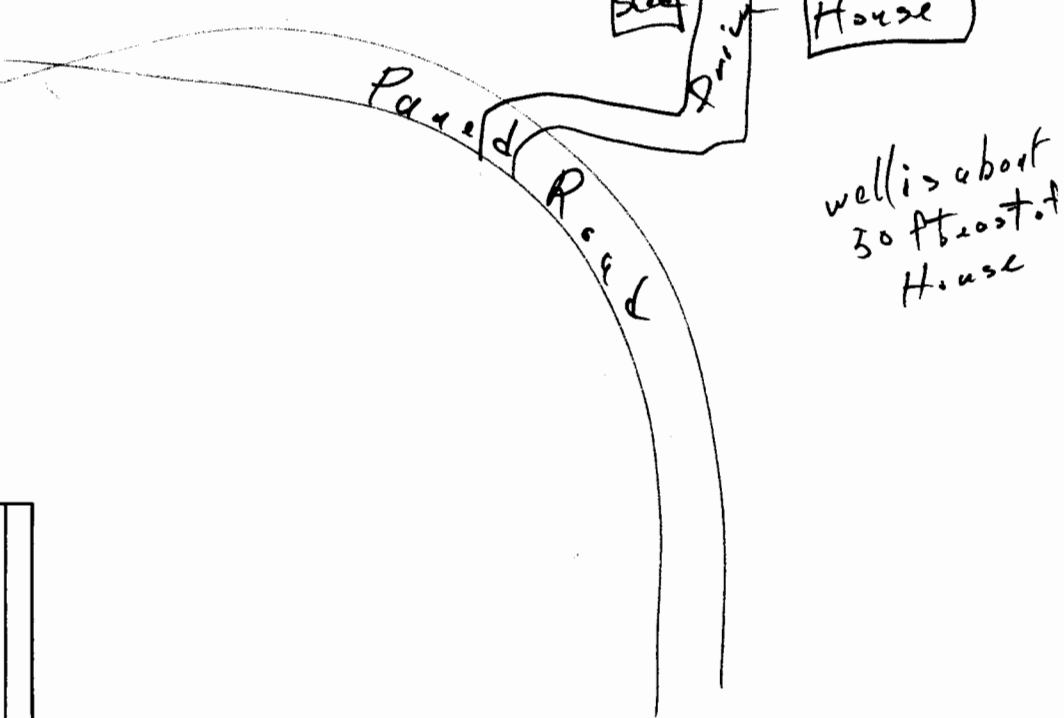

North

