


1	LOCATION OF WATER WELL:	Fraction	Section	Number	Township	Number	Range	Number
	County: Johnson	NW 1/4 NW 1/4 SE 1/4	20		T 12 S		R 22	(E) W

Distance and direction from nearest town or city street address of well if located within city?

Approximately 3/4 mile north and 1/2 mile west of DeSoto

2 WATER WELL OWNER: City of Olathe
 RR#, St. Address, Box # P.O Box 768
 City, State, ZIP Code Olathe, KS 66051-0768
 Board of Agriculture, Division of Water Resources
 Application Number:

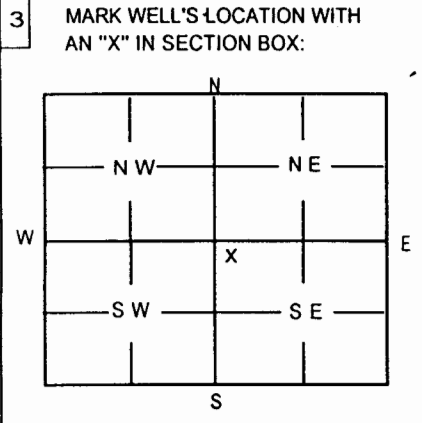

4 DEPTH OF WELL 47 ft
 WELL'S STATIC WATER LEVEL Not checked ft.
 WELL WAS USED AS:
 1 Domestic 5 Public Water Supply 9 Dewatering
 2 Irrigation 6 Oil Field Water Supply 10 Monitoring Well
 3 Feedlot 7 Domestic (Lawn & Garden) 11 Injection Well
 4 Industrial 8 Air Conditioning 12 Other Observation
 Was a chemical / bacteriological sample submitted to Department? Yes No
 If yes, mo/day/yr sample was submitted _____
 Water Well Disinfected: Yes No _____

5 TYPE OF BLANK CASING USED:
 1 Steel 3 RMP (SR) 5 Wrought 7 Fiberglass 9 Other (Specify below)
 2 PVC 4 ABS 6 Asbestos-Cement 8 Concrete Tile
 Blank casing diameter 2 in. Was casing pulled? Yes No
 Casing height above or below land surface 120 in. If yes, how much _____

6 GROUT PLUG MATERIAL: 1 Neat Cement 2 Cement grout 3 Bentonite 4 Other Bentonite Holeplug
 Grout Plug Intervals: From _____ ft. to _____ ft., From _____ ft. to _____ ft. From 0 ft. to 47 ft.
 What is the nearest source of possible contamination:
 1 Septic tank 6 Seepage pit 11 Fuel storage 16 Other (specify below)
 2 Sewer lines 7 Pit privy 12 Fertilizer storage
 3 Watertight sewer lines 8 Sewage lagoon 13 Insecticide storage None known
 4 Lateral lines 9 Feedyard 14 Abandoned water well
 5 Cess Pool 10 Livestock pens 15 Oil well/Gas well
 Direction from well? _____ How many feet? _____

FROM	TO	PLUGGING MATERIALS
47	0	Bentonite Holeplug

7 CONTRACTOR'S OR LANDOWNER'S CERTIFICATION: This water well was plugged under my jurisdiction and was completed on (mo/day/year) 11-08-06 and this record is true to the best of my knowledge and belief. Kansas Water Well Contractor's License No. 185 This Water Well Record was completed on (mo/day/year) 11-20-06 under the business name of Clarke Well & Equipment, Inc.
 by (signature) *[Signature]*

INSTRUCTIONS: Use typewriter or ball point pen. Please press firmly and print clearly. Please fill in blanks, underline or circle the correct answers. Send top three copies to Kansas Department of Health & Environment, Bureau of Water, Topeka, Kansas 66620-0001. Telephone: 785/296-3565. Send one to Water Well Owner and retain one for your records.