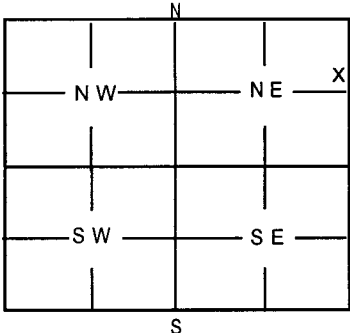


1	LOCATION OF WATER WELL: County: <u>Leavenworth</u>	Fraction <u>SE 1/4 NE 1/4 NE 1/4</u>	Section Number <u>28</u>	Township Number <u>T 12 S</u>	Range Number <u>R 22 E</u>																								
Distance and direction from nearest town or city street address of well if located within city? <u>Approximately 1/4 mile north of DeSoto</u>																													
2	WATER WELL OWNER: <u>City of Olathe</u> RR#, St. Address, Box # <u>P.O. Box 768</u> City, State, ZIP Code <u>Olathe, KS 66051-0768</u> Board of Agriculture, Division of Water Resources Application Number:																												
3	MARK WELL'S LOCATION WITH AN "X" IN SECTION BOX: 																												
4	DEPTH OF WELL <u>60</u> ft WELL'S STATIC WATER LEVEL <u>30</u> ft. WELL WAS USED AS: 1 Domestic 5 Public Water Supply 9 Dewatering 2 Irrigation 6 Oil Field Water Supply 10 Monitoring Well 3 Feedlot 7 Domestic (Lawn & Garden) 11 Injection Well 4 Industrial 8 Air Conditioning <u>12 Other</u> <u>Observation</u> Was a chemical / bacteriological sample submitted to Department? Yes _____ No ☒ If yes, mo/day/yr sample was submitted _____ Water Well Disinfected: Yes ☒ No _____																												
5	TYPE OF BLANK CASING USED: 1 Steel 3 RMP (SR) 5 Wrought 7 Fiberglass 9 Other (Specify below) <u>2 PVC</u> 4 ABS 6 Asbestos-Cement 8 Concrete Tile Blank casing diameter <u>2</u> in. Was casing pulled? Yes _____ No ☒ Casing height above or <u>below</u> land surface <u>48</u> in. If yes, how much _____																												
6	GROUT PLUG MATERIAL: 1 Neat Cement 2 Cement grout 3 Bentonite <u>4 Other</u> <u>Bentonite Holeplug</u> Grout Plug Intervals: From _____ ft. to _____ ft., From _____ ft. to _____ ft. From <u>30</u> ft. to <u>4</u> ft. What is the nearest source of possible contamination: 1 Septic tank 6 Seepage pit 11 Fuel storage <u>16 Other (specify below)</u> 2 Sewer lines 7 Pit privy 12 Fertilizer storage 3 Watertight sewer lines 8 Sewage lagoon 13 Insecticide storage <u>None known</u> 4 Lateral lines 9 Feedyard 14 Abandoned water well 5 Cess Pool 10 Livestock pens 15 Oil well/Gas well Direction from well? _____ How many feet? _____																												
<table border="1" style="width:100%; border-collapse: collapse;"> <thead> <tr> <th style="width:10%;">FROM</th> <th style="width:10%;">TO</th> <th style="width:80%;">PLUGGING MATERIALS</th> </tr> </thead> <tbody> <tr> <td style="text-align: center;">60</td> <td style="text-align: center;">30</td> <td>Crushed Rock</td> </tr> <tr> <td style="text-align: center;">30</td> <td style="text-align: center;">4</td> <td>Bentonite Holeplug</td> </tr> <tr> <td style="text-align: center;">4</td> <td style="text-align: center;">0</td> <td>Compacted Soil</td> </tr> <tr><td> </td><td> </td><td> </td></tr> <tr><td> </td><td> </td><td> </td></tr> <tr><td> </td><td> </td><td> </td></tr> <tr><td> </td><td> </td><td> </td></tr> </tbody> </table>						FROM	TO	PLUGGING MATERIALS	60	30	Crushed Rock	30	4	Bentonite Holeplug	4	0	Compacted Soil												
FROM	TO	PLUGGING MATERIALS																											
60	30	Crushed Rock																											
30	4	Bentonite Holeplug																											
4	0	Compacted Soil																											
7	CONTRACTOR'S OR LANDOWNER'S CERTIFICATION: This water well was plugged under my jurisdiction and was completed on (mo/day/year) <u>03-20-07</u> and this record is true to the best of my knowledge and belief. Kansas Water Well Contractor's License No. <u>185</u> This Water Well Record was completed on (mo/day/year) <u>03-23-07</u> under the business name of <u>Clarke Well & Equipment, Inc.</u> by (signature) <u>[Signature]</u>																												
INSTRUCTIONS: Use typewriter or ball point pen. Please press firmly and print clearly. Please fill in blanks, underline or circle the correct answers. Send top three copies to Kansas Department of Health & Environment, Bureau of Water, Topeka, Kansas 66620-0001. Telephone: 785/296-3565. Send one to Water Well Owner and retain one for your records.																													