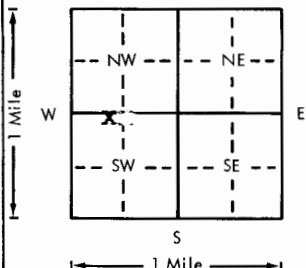
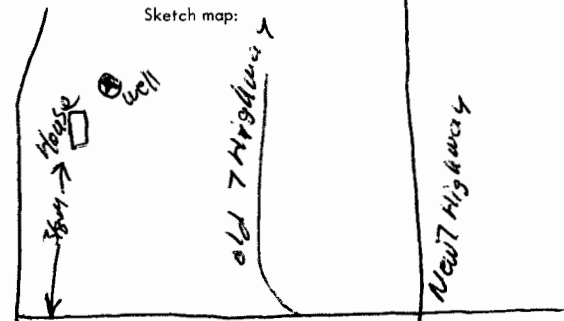


USE TYPEWRITER OR BALL
POINT PEN-PRESS FIRMLY,
PRINT CLEARLY.

WATER WELL RECORD
KSA 82a-1201-1215

Kansas Department of Health and
Environment-Division of Environment
(Water well Contractors)
Topeka, Kansas 66620

CBC

1. Location of well:	County Johnson	Fraction NE SW NE $\frac{1}{4}$ NW $\frac{1}{4}$ SW $\frac{1}{4}$	Section number 4	Township number T 12S S R	Range number 23E E/W
2. Distance and direction from nearest town or city: 8 mi. west of Shawnee, Kansas.			3. Owner of well: Richard Hathaway R.R. or street: R. 1 Box 447B City, state, zip code: Desoto, Kansas 66018		
4. Locate with "X" in section below: 			Sketch map: 		
5. Type and color of material			6. Bore hole dia. 7 3/8 . Completion date 8/29/77 Well depth 200 ft.		
surface			7. <input checked="" type="checkbox"/> Cable tool <input checked="" type="checkbox"/> Rotary <input type="checkbox"/> Driven <input type="checkbox"/> Dug <input type="checkbox"/> Hollow rod <input type="checkbox"/> Jetted <input type="checkbox"/> Bored <input type="checkbox"/> Reverse rotary		
clay			8. Use: <input type="checkbox"/> Domestic <input type="checkbox"/> Public supply <input type="checkbox"/> Industry DRY HOLE <input type="checkbox"/> Air conditioning <input type="checkbox"/> Stock <input type="checkbox"/> Lawn <input type="checkbox"/> Oil field water <input type="checkbox"/> Other		
lime (soft, yellow)			9. DRY HOLE Material <input type="checkbox"/> Height: Above or below Threaded <input type="checkbox"/> Welded <input type="checkbox"/> Surface <input type="checkbox"/> in. RMP <input type="checkbox"/> PVC <input type="checkbox"/> Weight <input type="checkbox"/> lbs./ft. Dia. <input type="checkbox"/> in. to <input type="checkbox"/> ft. depth Wall Thickness: inches or Dia. <input type="checkbox"/> in. to <input type="checkbox"/> ft. depth gage No. <input type="checkbox"/>		
shale (grey-green)			10. Screens: Manufacturer's name <input type="checkbox"/> DRY HOLE Type <input type="checkbox"/> Dia. <input type="checkbox"/> Slot/gauze <input type="checkbox"/> Length <input type="checkbox"/> Set between <input type="checkbox"/> ft. and <input type="checkbox"/> ft. <input type="checkbox"/> ft. and <input type="checkbox"/> ft. Gravel pack? <input type="checkbox"/> Size range of material <input type="checkbox"/>		
lime (grey)			11. Static water level: <input type="checkbox"/> mo./day/yr. DRY HOLE ft. below land surface Date <input type="checkbox"/>		
shale (grey)			12. Pumping level below land surfaces: ft. after <input type="checkbox"/> hrs. pumping <input type="checkbox"/> g.p.m. ft. after <input type="checkbox"/> hrs. pumping <input type="checkbox"/> g.p.m. Estimated maximum yield <input type="checkbox"/> g.p.m.		
lime (lt. grey)			13. Water sample submitted: <input type="checkbox"/> mo./day/yr. DRY HOLE No Date <input type="checkbox"/>		
shale (grey)			14. Well head completion: DRY HOLE <input type="checkbox"/> Inches above grade		
lime (med. grey)			15. Well grouted? <input type="checkbox"/> DRY HOLE <input type="checkbox"/> Cement <input type="checkbox"/> Bentonite <input type="checkbox"/> Concrete Depth: From <input type="checkbox"/> ft. to <input type="checkbox"/> ft.		
shale (grey)			16. DRY HOLE <input type="checkbox"/> of possible contamination: ft. <input type="checkbox"/> Direction <input type="checkbox"/> Type <input type="checkbox"/> Well disinfected upon completion? <input type="checkbox"/> Yes <input type="checkbox"/> No		
lime (grey)			17. DRY HOLE <input type="checkbox"/> Not installed Manufacturer's name <input type="checkbox"/> Model number <input type="checkbox"/> HP <input type="checkbox"/> Volts <input type="checkbox"/> Length of drop pipe <input type="checkbox"/> ft. capacity <input type="checkbox"/> g.p.m. Type: <input type="checkbox"/> Submersible <input type="checkbox"/> Turbine <input type="checkbox"/> Jet <input type="checkbox"/> Reciprocating <input type="checkbox"/> Centrifugal <input type="checkbox"/> Other		
shale (black, slaty)			20. Water well contractor's certification: This well was drilled under my jurisdiction and this report is true to the best of my knowledge and belief. F.E. Young Drilling Co. 240 Business name License No. <input type="checkbox"/> Address 6355 Robinhood Ln. Merriam Signed F.E. Young Date 9-20-77 Authorized representative		
lime (grey)					
lime (green-grey)					
lime (white)					
shale (white)					
shale (grey, sandy)					
lime (grey)					
DRY HOLE ----- PLUGGED					
(Use a second sheet if needed)					
18. Elevation: 890 Topography: <input checked="" type="checkbox"/> Hill <input type="checkbox"/> Slope <input type="checkbox"/> Upland <input type="checkbox"/> Valley	19. Remarks: 970				

Forward the white, blue and pink copies to the Department of Health and Environment

Form WWC-5