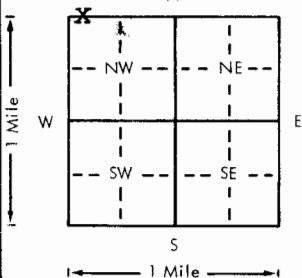


USE TYPEWRITER OR BALL
POINT PEN-PRESS FIRMLY,
PRINT CLEARLY.

WATER WELL RECORD
KSA 82a-1201-1215

Kansas Department of Health and
Environment-Division of Environment
(Water well Contractors)
Topeka, Kansas 66620

1. Location of well:		County <u>Johnson</u> <u>Wendell</u>	Fraction <u>NW 1/4 NW 1/4 NW 1/4</u>	Section number <u>11</u>	Township number <u>T 12 S R</u>	Range number <u>23 E/W</u>
2. Distance and direction from nearest town or city: <u>2 1/2 miles SE</u>		3. Owner of well: <u>Mr. Gene Brassfield</u>				
Street address of well location if in city: <u>of Bonner Springs, Ks.</u>		R.R. or street: <u>1956 Sleepy Hollow</u>				
		City, state, zip code: <u>Olathe, Kansas</u>				
4. Locate with "X" in section below:		Sketch map:		6. Bore hole dia. <u>8</u> in. Completion date <u>12-18-78</u>		
				Well depth <u>1000</u>		
5. Type and color of material		From	To	7. <u>X</u> Cable tool <u>X</u> Rotary <u> </u> Driven <u> </u> Dug <u> </u>		
<u>Top Soil</u>		<u>0</u>	<u>2</u>	<u> </u> Hollow rod <u> </u> Jetted <u> </u> Bored <u> </u> Reverse rotary		
<u>Clay</u>		<u>2</u>	<u>25</u>	8. Use: <u>X</u> Domestic <u> </u> Public supply <u> </u> Industry <u> </u>		
<u>Sand & Gravel</u>		<u>25</u>	<u>40</u>	<u> </u> Irrigation <u> </u> Air conditioning <u> </u> Stock <u> </u>		
<u>Sand</u>		<u>40</u>	<u>50</u>	<u> </u> Lawn <u> </u> Oil field water <u> </u> Other <u> </u>		
<u>Lime</u>		<u>50</u>	<u>56</u>	9. Casing: Material <u>PL</u> Height: Above or below		
<u>Black Slate</u>		<u>56</u>	<u>59</u>	Threaded <u> </u> Welded <u>X</u> Surface <u> </u> <u>18</u> in.		
<u>Lime</u>		<u>59</u>	<u>62</u>	RMP <u> </u> PVC <u>XX</u> Weight <u> </u> lbs./ft.		
<u>Shale</u>		<u>62</u>	<u>74</u>	Dia. <u>5</u> in. to <u>101</u> ft. depth Wall Thickness: inches or		
<u>Lime</u>		<u>74</u>	<u>84</u>	Dia. <u> </u> in. to <u> </u> ft. depth gage No. <u>.265</u>		
<u>Slate</u>		<u>84</u>	<u>89</u>	10. Screen: Manufacturer's name <u>Slotted Pipe</u>		
<u>Lime</u>		<u>89</u>	<u>100</u>	<u>Vinylplex, Inc.</u>		
				Type <u>PVC</u> Dia. <u>5</u> "		
				Slot/gauze <u>.06 1/16</u> Length <u>10'</u>		
				Set between <u>30</u> ft. and <u>40</u> ft.		
				Gravel pack? <u>X</u> Size range of material <u>1/4 - 1/8</u>		
				11. Static water level: <u>30</u> ft. below land surface Date <u>12-18-78</u>		
				12. Pumping level below land surfaces:		
				<u> </u> ft. after <u> </u> hrs. pumping <u> </u> g.p.m.		
				<u> </u> ft. after <u> </u> hrs. pumping <u> </u> g.p.m.		
				Estimated maximum yield <u>12</u> g.p.m.		
				13. Water sample submitted: <u> </u> mo./day/yr.		
				<u> </u> Yes <u>XX</u> No Date <u> </u>		
				14. Well head completion: <u> </u> Pitless adapter <u>18</u> inches above grade		
				15. Well grouted? <u>Yes</u>		
				With: <u>X</u> Neat cement <u> </u> Bentonite <u> </u> Concrete <u> </u>		
				Depth: From <u>3</u> ft. to <u>15</u> ft.		
				16. Nearest source of possible contamination:		
				ft. <u>250'</u> Direction <u>west</u> Type <u>septic</u>		
				Well disinfected upon completion? <u>XX</u> Yes <u> </u> No <u> </u>		
				17. Pump: <u>X</u> Not installed		
				Manufacturer's name <u> </u>		
				Model number <u> </u> HP <u> </u> Volts <u> </u>		
				Length of drop pipe <u> </u> ft. capacity <u> </u> g.p.m.		
				Type:		
				<u> </u> Submersible <u> </u> Turbine		
				<u> </u> Jet <u> </u> Reciprocating		
				<u> </u> Centrifugal <u> </u> Other <u> </u>		
18. Elevation:		19. Remarks:		20. Water well contractor's certification:		
Topography: <u> </u> Hill <u> </u> Slope <u> </u> Upland <u> </u> Valley <u> </u>				This well was drilled under my jurisdiction and this report is true to the best of my knowledge and belief.		
				<u>BREUER, INC.</u> <u>174</u>		
				Business name <u> </u> License No. <u> </u>		
				Address <u>Box 147, Basehor, Ks.</u>		
				Signed <u> </u> Date <u>12-20-78</u>		
				Authorized Representative <u> </u>		

Forward the white, blue and pink copies to the Department of Health and Environment

Form WWC-5