


1 LOCATION OF WATER WELL: Fraction Section Number Township Number Range Number  
 County: JOHNSON SE 1/4 NW 1/4 SW 1/4 1 12 23 EW

Distance and direction from nearest town or city street address of well if located within city?

2 WATER WELL OWNER: JOHNSON COUNTY Land Fill  
 RR #, St. Address, Box #: 18181 W 53rd St.  
 City, State, ZIP Code : SHAWNEE, KS 66217 Board of Agriculture, Division of Water Resources  
 Application Number:

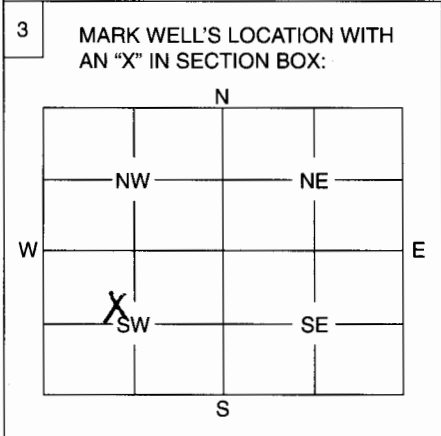

4 DEPTH OF WELL 169.83 ft.  
 WELL'S STATIC WATER LEVEL 136.54 ft.  
 WELL WAS USED AS:  
 1 Domestic 2 Irrigation 3 Feedlot 4 Industrial 5 Public Water Supply 6 Oil Field Water Supply 7 Domestic (Lawn & Garden) 8 Air Conditioning 9 Dewatering 10 Monitoring Well 11 Injection Well 12 Other  
 Was a chemical / bacteriological sample submitted to Department? Yes No X  
 If yes, mo/day/yr sample was submitted  
 Water Well Disinfected: Yes No X

5 TYPE OF BLANK CASING USED:  
 1 Steel 2 PVC 3 RMP (SR) 4 ABS 5 Wrought 6 Asbestos-Cement 7 Fiberglass 8 Concrete Tile 9 Other (Specify below)  
 Blank casing diameter 2 in. Was casing pulled? Yes X No If yes, how much 26.5 Then overdrilled  
 Casing height above or below land surface 34 in.

6 GROUT PLUG MATERIAL: 1 Neat cement 2 Cement grout 3 Bentonite 4 Other  
 What is the nearest source of possible contamination:  
 1 Septic tank 2 Sewer lines 3 Watertight sewer lines 4 Lateral lines 5 Cess pool 6 Seepage pit 7 Pit privy 8 Sewage lagoon 9 Feedyard 10 Livestock pens 11 Fuel storage 12 Fertilizer storage 13 Insecticide storage 14 Abandoned water well 15 Oil well/Gas well 16 Other (specify below) M.S.W.L.F.  
 Direction from well? How many feet?

FROM	TO	PLUGGING MATERIALS
173	57	1/4" Bentonite Pel Plugs
57	0	3/8 Bentonite chips

7 CONTRACTOR'S OF LANDOWNER'S CERTIFICATION: This water well was plugged under my jurisdiction and was completed on (mo/day/year) 6-25-07 and this record is true to the best of my knowledge and belief. Kansas Water Well Contractor's License No. 650 This Water Well Record was completed on (mo/day/year) under the business name of D.F.S. by (signature) Ron L... ..

INSTRUCTIONS: Use typewriter or ball point pen. Please press firmly and print clearly. Please fill in blanks, underline or circle the correct answers. Send top three copies to Kansas Department of Health and Environment, Bureau of Water, Geology Section, 1000 SW Jackson St., Ste. 420, Topeka, Kansas 66612-1367. Telephone: 785/296-5522. Send one to Water Well Owner and retain one for your records.