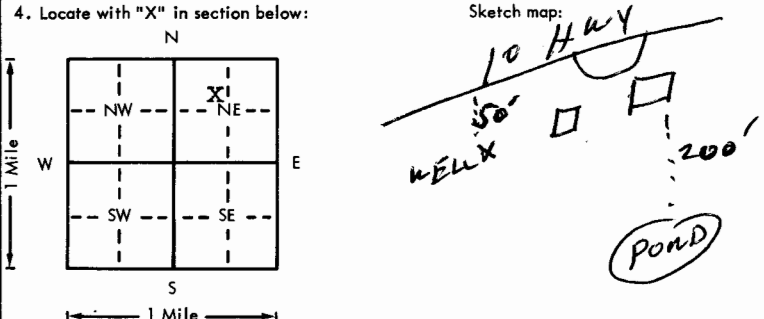


USE TYPEWRITER OR BALL POINT PEN-PRESS FIRMLY, PRINT CLEARLY.

WATER WELL RECORD
KSA 82a-1201-1215

Kansas Department of Health and Environment-Division of Environment
(Water well Contractors)
Topeka, Kansas 66620

ADB

1. Location of well:	County Johnson	Fraction NW 1/4 SE 1/4 NE 1/4	Section number 16	Township number T 12S S	Range number R 24E E/W	
2. Distance and direction from nearest town or city: Street address of well location if in city: in city of Shawnee 1362 Midland Dr.			3. Owner of well: Victor M. Macek Jr. R.R. or street: 1362 Midland Dr. City, state, zip code: Shawnee, Ks. 66203	
4. Locate with "X" in section below: 			6. Bore hole dia. 6 1/8 Completion date 9-20-76 Well depth 244 ft.	
5. Type and color of material			7. <input type="checkbox"/> Cable tool <input checked="" type="checkbox"/> Rotary <input type="checkbox"/> Driven <input type="checkbox"/> Dug <input type="checkbox"/> Hollow rod <input type="checkbox"/> Jetted <input type="checkbox"/> Bored <input type="checkbox"/> Reverse rotary	
<table border="1" style="width:100%; border-collapse: collapse;"> <thead> <tr> <th></th> <th>From</th> <th>To</th> </tr> </thead> <tbody> <tr><td>surface</td><td>0</td><td>2</td></tr> <tr><td>clay</td><td>2</td><td>18</td></tr> <tr><td>shale (gray)</td><td>18</td><td>22</td></tr> <tr><td>lime</td><td>22</td><td>30</td></tr> <tr><td>shale (grey)</td><td>30</td><td>47</td></tr> <tr><td>lime</td><td>47</td><td>51</td></tr> <tr><td>shale (lt. gray)</td><td>51</td><td>62</td></tr> <tr><td>lime (brown)</td><td>62</td><td>82</td></tr> <tr><td>shale (lt. Grey)</td><td>82</td><td>123</td></tr> <tr><td>lime</td><td>123</td><td>140</td></tr> <tr><td>shale (dark)</td><td>140</td><td>151</td></tr> <tr><td>lime (lt. Grey)</td><td>151</td><td>161</td></tr> <tr><td>shale (med. Gray)</td><td>161</td><td>164</td></tr> <tr><td>lime</td><td>164</td><td>180</td></tr> <tr><td>shale (dk. gray)</td><td>180</td><td>197</td></tr> <tr><td>lime</td><td>197</td><td>202</td></tr> <tr><td>shale (dark)</td><td>202</td><td>206</td></tr> <tr><td>lime</td><td>206</td><td>235</td></tr> <tr><td>slate (black, slaty shale)</td><td>235</td><td>244</td></tr> <tr><td>DRY HOLE --- PLUGGED</td><td></td><td></td></tr> </tbody> </table>				From	To	surface	0	2	clay	2	18	shale (gray)	18	22	lime	22	30	shale (grey)	30	47	lime	47	51	shale (lt. gray)	51	62	lime (brown)	62	82	shale (lt. Grey)	82	123	lime	123	140	shale (dark)	140	151	lime (lt. Grey)	151	161	shale (med. Gray)	161	164	lime	164	180	shale (dk. gray)	180	197	lime	197	202	shale (dark)	202	206	lime	206	235	slate (black, slaty shale)	235	244	DRY HOLE --- PLUGGED			8. Use: DRY HOLE <input type="checkbox"/> Public supply <input type="checkbox"/> Industry <input type="checkbox"/> Irrigation <input type="checkbox"/> Air conditioning <input type="checkbox"/> Stock <input type="checkbox"/> Lawn <input type="checkbox"/> Oil field water <input type="checkbox"/> Other		
			9. Casing: Material DRY HOLE Height: Above or below Threaded <input type="checkbox"/> Welded <input type="checkbox"/> Surface <input type="checkbox"/> in. RMP <input type="checkbox"/> PVC <input type="checkbox"/> Weight <input type="checkbox"/> lbs./ft. Dia. <input type="checkbox"/> in. to <input type="checkbox"/> ft. depth Wall Thickness: inches or Dia. <input type="checkbox"/> in. to <input type="checkbox"/> ft. depth gage No. <input type="checkbox"/>	
			10. Screen manufacturer's name DRY HOLE Type <input type="checkbox"/> Dia. <input type="checkbox"/> Slot/gauze <input type="checkbox"/> Length <input type="checkbox"/> Set between <input type="checkbox"/> ft. and <input type="checkbox"/> ft. <input type="checkbox"/> ft. and <input type="checkbox"/> ft. Gravel pack? <input type="checkbox"/> Size range of material <input type="checkbox"/>	
			11. Static water level: DRY HOLE mo./day/yr. <input type="checkbox"/> ft. below land surface Date <input type="checkbox"/>	
			12. Pumping level below land surfaces: DRY HOLE <input type="checkbox"/> ft. after <input type="checkbox"/> hrs. pumping <input type="checkbox"/> g.p.m. <input type="checkbox"/> ft. after <input type="checkbox"/> hrs. pumping <input type="checkbox"/> g.p.m. Estimated maximum yield <input type="checkbox"/> g.p.m.	
			13. Water sample submitted: DRY HOLE mo./day/yr. <input type="checkbox"/> Yes <input type="checkbox"/> No Date <input type="checkbox"/>	
			14. Pitless adapter: DRY HOLE <input type="checkbox"/> Pitless adapter <input type="checkbox"/> Inches above grade	
			15. Well grouted? DRY HOLE With: <input type="checkbox"/> Bentonite <input type="checkbox"/> Concrete Depth: From <input type="checkbox"/> ft. to <input type="checkbox"/> ft.	
			16. Nearest source of possible contamination: DRY HOLE ft. <input type="checkbox"/> Direction <input type="checkbox"/> Type <input type="checkbox"/> Well disinfected upon completion? <input type="checkbox"/> Yes <input type="checkbox"/> No	
			17. Pump: DRY HOLE Not installed Manufacturer's name DRY HOLE Model number <input type="checkbox"/> HP <input type="checkbox"/> Volts <input type="checkbox"/> Length of drop pipe <input type="checkbox"/> ft. capacity <input type="checkbox"/> g.p.m. Type: <input type="checkbox"/> Submersible <input type="checkbox"/> Turbine <input type="checkbox"/> Jet <input type="checkbox"/> Reciprocating <input type="checkbox"/> Centrifugal <input type="checkbox"/> Other	
18. Elevation: 980 Topography: 990 <input type="checkbox"/> Hill <input checked="" type="checkbox"/> Slope <input type="checkbox"/> Upland <input type="checkbox"/> Valley			19. Remarks: Customer is aware of State regulation and agrees to install a 4' square re-enforced concrete platform around top of well. X	
			20. Water well contractor's certification: This well was drilled under my jurisdiction and this report is true to the best of my knowledge and belief. F. E. Young Drilling 240 Business name 6355 Robinhood Ln. License No. Address FE Young Date 9-27-76 Signed FE Young Authorized representative	

Forward the white, blue and pink copies to the Department of Health and Environment

Form WWC-5

JR
12 24E 16 NUSSE
T
R
Sec
1/4 1/4 1/4