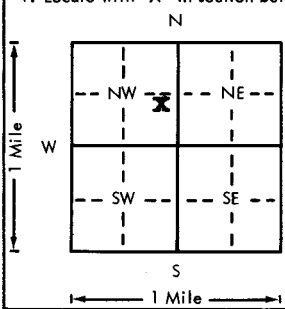
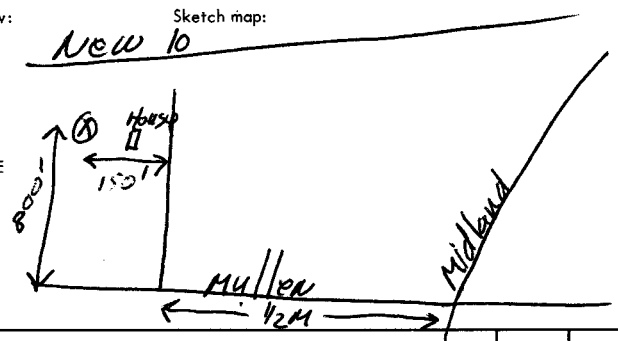


USE TYPEWRITER OR BALL POINT PEN-PRESS FIRMLY, PRINT CLEARLY.

WATER WELL RECORD
KSA 82a-1201-1215

Kansas Department of Health and Environment-Division of Environment
(Water well Contractors)
Topeka, Kansas 66620

SW BDC

1. Location of well:	County Johnson	Fraction NW SE 1/4 NW 1/4	Section number 16	Township number T 12 S	Range number R 24E
2. Distance and direction from nearest town or city: 3 mi. west of Shawnee, Ks.		3. Owner of well: T. G. Cernich R.R. or street: 6000 Mullen City, state, zip code: Shawnee, Ks. 66216			
4. Locate with "X" in section below: 			Sketch map: 		
5. Type and color of material surface			From	To	6. Bore hole dia. 7 3/8 in. Completion date 8/1/77 Well depth 135 ft.
shale (grey)			0	7	7. <input type="checkbox"/> Cable tool <input checked="" type="checkbox"/> Rotary <input type="checkbox"/> Driven <input type="checkbox"/> Dug <input type="checkbox"/> Hollow rod <input type="checkbox"/> Jetted <input type="checkbox"/> Bored <input type="checkbox"/> Reverse rotary
lime (brown)			7	13	8. Use: <input type="checkbox"/> Domestic <input type="checkbox"/> Public supply <input type="checkbox"/> Industry DRY HOLE <input type="checkbox"/> Air conditioning <input type="checkbox"/> Stock <input type="checkbox"/> Lawn <input type="checkbox"/> Oil field water <input type="checkbox"/> Other
shale (grey)			13	22	9. Casing: Material _____ Height: Above or below Threading DRY HOLE _____ Surface _____ in. RMP _____ PVC _____ Weight _____ lbs./ft. Dia. _____ in. to _____ ft. depth Wall Thickness: inches or Dia. _____ in. to _____ ft. depth gage No. _____
lime (lt. grey)			22	36	10. Screen: Manufacturer's name _____ DRY HOLE Type DRY HOLE Dia. _____ Slot/gauze _____ Length _____ Set between _____ ft. and _____ ft. _____ ft. and _____ ft.
shale (grey)			36	41	Gravel pack? _____ Size range of material _____
lime (white)			41	55	11. Static water level: _____ mo./day/yr. DRY HOLE _____ ft. below land surface Date _____
shale (grey)			55	71	12. Pumping level below land surfaces: DRY HOLE _____ ft. after _____ hrs. pumping _____ g.p.m. _____ ft. after _____ hrs. pumping _____ g.p.m. Estimated maximum yield _____ g.p.m.
lime (white)			71	72	13. Water sample submitted: _____ mo./day/yr. DRY HOLE No Date _____
shale (grey)			72	75	14. Well head completion: DRY HOLE _____ inches above grade
lime (white)			75	116	15. Well grouted? _____ DRY HOLE With _____ cement _____ Bentonite _____ Concrete Depth: From _____ ft. to _____ ft.
shale (grey)			116	122	16. Nearest source of possible contamination: DRY HOLE _____ ft. Direction _____ Type _____ Well disinfected upon completion? _____ Yes _____ No
lime (grey)			122	126	17. Pump: _____ Not installed DRY HOLE Manufacturer's name _____ Model number _____ HP _____ Volts _____ Length of drop pipe _____ ft. capacity _____ g.p.m. Type: <input type="checkbox"/> Submersible <input type="checkbox"/> Turbine <input type="checkbox"/> Jet <input type="checkbox"/> Reciprocating <input type="checkbox"/> Centrifugal <input type="checkbox"/> Other
shale (grey)			126	128	
sandstone (grey)			128	130	
shale (grey)			130	135	
DRY HOLE ----- PLUGGED					
(Use a second sheet if needed)					
18. Elevation: 920' 972' Topography: <input type="checkbox"/> Hill <input type="checkbox"/> Slope <input type="checkbox"/> Upland <input checked="" type="checkbox"/> Valley	19. Remarks:		20. Water well contractor's certification: This well was drilled under my jurisdiction and this report is true to the best of my knowledge and belief. F.E. Young Drilling Co. 240 Business name _____ License No. _____ Address 6355 Robinhood Ln. Merriam Signed F.E. Young Date 10-20-77 Authorized representative		

12 240 16 NE SEND 1/4 1/4 1/4

Forward the white, blue and pink copies to the Department of Health and Environment

Form WWC-5