


1 LOCATION OF WATER WELL:	Fraction NE ¼ SE ¼ SE ¼	Section Number 18	Township Number T 12 S	Range Number R 24 E
---------------------------	---	-----------------------------	----------------------------------	-------------------------------

Distance and direction from nearest town or city street address of well if located within city?
~~In city~~ K. C. Kan 63rd + Santa Fe Drive, Shawnee, Ks

2 WATER WELL OWNER: Amoco Oil Company
RR#, St. Address, Box # : P.O. Box 419750
City, State, ZIP Code : Kansas City, Mo. 64141-6750

Board of Agriculture, Division of Water Resources
Application Number:

3 LOCATE WELL'S LOCATION WITH AN "X" IN SECTION BOX: 4 DEPTH OF COMPLETED WELL: 18' 1" ft. ELEVATION: 12 ft. 2 ft. 2 ft. 2 ft.

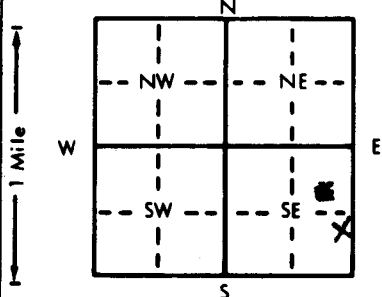

4 DEPTH OF COMPLETED WELL.....18' 1" ft. ELEVATION:
 Depth(s) Groundwater Encountered 1.....12 ft. 2..... ft. 3..... ft.
 WELL'S STATIC WATER LEVEL ft. below land surface measured on mo/day/yr 9/30/87
 Pump test data: Well water was ft. after hours pumping gpm
 Est. Yield gpm: Well water was ft. after hours pumping gpm
 Bore Hole Diameter.....8 in. to ft., and..... in. to ft.
 WELL WATER TO BE USED AS: 5 Public water supply 8 Air conditioning 11 Injection well
 1 Domestic 3 Feedlot 6 Oil field water supply 9 Dewatering 12 Other (Specify below)
 2 Irrigation 4 Industrial 7 Lawn and garden only 10 Observation well
 Was a chemical/bacteriological sample submitted to Department? Yes.....No.....X; If yes, mo/day/yr sample was submitted
 Water Well Disinfected? Yes No X

5 TYPE OF BLANK CASING USED:		5 Wrought iron	8 Concrete tile	CASING JOINTS: Glued Clamped <input checked="" type="checkbox"/>	
1 Steel	3 RMP (SR)	6 Asbestos-Cement	9 Other (specify below)	Welded	
2 <u>PVC</u>	4 ABS	7 Fiberglass		Threaded	
Blank casing diameter 2 . . . in. to ft., Dia		. . . in. to ft., Dia		. . . in. to ft.	
Casing height above land surface 0 . . . in., weight		. . . lbs./ft. Wall thickness or gauge No.		Sch 40	

TYPE OF SCREEN OR PERFORATION MATERIAL:			<u>7 PVC</u>	10 Asbestos-cement
1 Steel	3 Stainless steel	5 Fiberglass	8 RMP (SR)	11 Other (specify)
2 Brass	4 Galvanized steel	6 Concrete tile	9 ABS	12 None used (open hole)

SCREEN OR PERFORATION OPENINGS ARE:

1 Continuous slot	<u>3 Mill slot</u>	5 Gauzed wrapped	8 Saw cut	11 None (open hole)
2 Louvered shutter	4 Key punched	6 Wire wrapped	9 Drilled holes	
		7 Torch cut	10 Other (specify)	

SCREEN-PERFORATED INTERVALS:	From	8	ft. to	18	ft., From	ft. to	ft.
	From		ft. to		ft., From	ft. to	ft.
GRAVEL PACK INTERVALS:	From	7	ft. to	18	ft., From	ft. to	ft.
	From		ft. to		ft., From	ft. to	ft.

6 GROUT MATERIAL: 1 Neat cement 2 Cement grout 3 Bentonite 4 Other concrete
Grout Intervals: From 1 ft. to 7 ft., From _____ ft. to _____ ft., From 0 ft. to 1 ft.

What is the nearest source of possible contamination:

1 Septic tank	4 Lateral lines	7 Pit privy	10 Livestock pens	14 Abandoned water well
2 Sewer lines	5 Cess pool	8 Sewage lagoon	<u>11 Fuel storage</u>	15 Oil well/Gas well
3 Watertight sewer lines	6 Seepage pit	9 Feedyard	12 Fertilizer storage	16 Other (specify below)
Direction from well? South			13 Insecticide storage
			How many feet? 8	

[illegible]

7 CONTRACTOR'S OR LANDOWNER'S CERTIFICATION: This water well was (1) constructed, (2) reconstructed, or (3) plugged under my jurisdiction and was completed on (mo/day/year) 9/30/87 and this record is true to the best of my knowledge and belief. Kansas 10/13/87

Water Well Contractor's License No. 400 This Water Well Record was completed on (month/day/yr) 11/1/00
under the business name of J & R Drilling Services, Inc. by (signature) Raymond Sears

INSTRUCTIONS: Use typewriter or ball point pen. **PLEASE PRESS FIRMLY** and **PRINT** clearly. Please fill in blanks, underline or circle the correct answers. Send top three copies to Kansas Department of Health and Environment, Office of Oil Field and Environmental Geology, Regulation and Permitting Section, Topeka, Kansas 66620-7500, Telephone: 913-862-9360. Send one to **WATER WELL OWNER** and retain one for your records.