

1 LOCATION OF WATER WELL: County: Johnson	Fraction NW 1/4 NW 1/4 SW 1/4	Section Number 23	Township Number T 12 S	Range Number R 24 EXX
---	---	-----------------------------	----------------------------------	--

Distance and direction from nearest town or city street address of well if located within city?

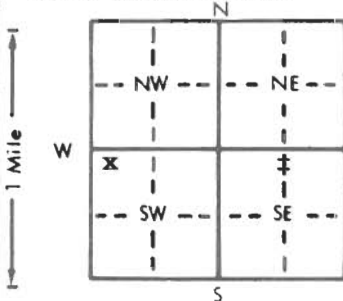
7741 Quivira Lenexa Ks.2 WATER WELL OWNER: **Amoco Oil Corp.**RR#, St. Address, Box # **8700 Indian Creek, Pkwy suite 10**

Board of Agriculture, Division of Water Resources

City, State, ZIP Code **Overland Park, KS. 66210**

Application Number:

3 LOCATE WELL'S LOCATION WITH AN "X" IN SECTION BOX:

4 DEPTH OF COMPLETED WELL: **18.5** ft. ELEVATION:Depth(s) Groundwater Encountered 1. **5** ft. 2. ft. 3. ft.WELL'S STATIC WATER LEVEL **9.07** ft. below land surface measured on mo/day/yr **1-10-90**

Pump test data: Well water was ft. after hours pumping gpm

Est. Yield gpm: Well water was ft. after hours pumping gpm

Bore Hole Diameter **6** in. to ft. and in. to ft.

WELL WATER TO BE USED AS: 5 Public water supply 8 Air conditioning 11 Injection well

1 Domestic 3 Feedlot 6 Oil field water supply 9 Dewatering 12 Other (Specify below)

2 Irrigation 4 Industrial 7 Lawn and garden only 10 Monitoring well

Was a chemical/bacteriological sample submitted to Department? Yes. No. **X**; If yes, mo/day/yr sample was submittedWater Well Disinfected? Yes No **X**

5 TYPE OF BLANK CASING USED:

1 Steel

3 RMP (SR)

5 Wrought iron

8 Concrete tile

CASING JOINTS: Glued Clamped

2 PVC

4 ABS

6 Asbestos-Cement

9 Other (specify below)

Welded

Blank casing diameter **2** in. to **3.0** ft. Dia.Casing height above land surface **-5' FT** in., weight lbs./ft. Wall thickness or gauge No. **SCH. 40**

7 Fiberglass

Threaded **X**

TYPE OF SCREEN OR PERFORATION MATERIAL:

1 Steel

3 Stainless steel

5 Fiberglass

7 PVC

10 Asbestos-cement

2 Brass

4 Galvanized steel

6 Concrete tile

8 RMP (SR)

11 Other (specify)

9 ABS

12 None used (open hole)

SCREEN OR PERFORATION OPENINGS ARE:

1 Continuous slot

3 Mill slot

5 Gauzed wrapped

8 Saw cut

11 None (open hole)

2 Louvered shutter

4 Key punched

6 Wire wrapped

9 Drilled holes

7 Torch cut

10 Other (specify)

SCREEN-PERFORATED INTERVALS:

From **3.0** ft. to **17.5** ft. From ft. to ft.

From ft. to ft. From ft. to ft.

GRAVEL PACK INTERVALS:

From **2.5** ft. to **13.5** ft. From ft. to ft.

From ft. to ft. From ft. to ft.

6 GROUT MATERIAL:

1 Neat cement

~~XX~~ Cement grout~~XX~~ Bentonite

4 Other

Grout Intervals: From **0** ft. to **1.5** ft. From **1.5** ft. to **2.5** ft. From ft. to ft.

What is the nearest source of possible contamination:

1 Septic tank

4 Lateral lines

7 Pit privy

10 Livestock pens

14 Abandoned water well

2 Sewer lines

5 Cess pool

8 Sewage lagoon

11 Fuel storage

15 Oil well/Gas well

3 Watertight sewer lines

6 Seepage pit

9 Feedyard

12 Fertilizer storage

16 Other (specify below)

13 Insecticide storage

Direction from well? **W.**How many feet? **50'**

FROM	TO	LITHOLOGIC LOG	FROM	TO	PLUGGING INTERVALS
0	.75	Asphalt & gravel	15.5	17.0	Lightbrown to Reddish yellow weath shale
.75	4.0	Fill - Clayey silt W/Gravel			
4.0	6.0	Very Dark Gray to Black Clayey silt			
6.0	9.0	Greenish Gray weathered shale			
15.0	15.5	Weather limestone			

7 CONTRACTOR'S OR LANDOWNER'S CERTIFICATION: This water well was (1) constructed, (2) reconstructed, or (3) plugged under my jurisdiction and was completed on (mo/day/year) **12/28/89** and this record is true to the best of my knowledge and belief. KansasWater Well Contractor's License No. **416**This Water Well Record was completed on (mo/day/yr) **1/10/90**under the business name of **TERRACON**by (signature) *W. S. Sember*