

1 LOCATION OF WATER WELL:	Fraction	Section Number	Township Number	Range Number
County: <u>Johnson</u>	NW 1/4 NW 1/4 SE 1/4	24	T 12 S	R 24E <u>E/W</u>

Distance and direction from nearest town or city street address of well if located within city?

11019 W. 75th Street, Shawnee, Kansas


Well #B-3

2 WATER WELL OWNER:	Fina Oil & Chemical Co.
RR#, St. Address, Box # :	8350 N. Central Expressway
City, State, ZIP Code :	Dallas, Texas 75206

Board of Agriculture, Division of Water Resources

Application Number:

3 LOCATE WELL'S LOCATION WITH AN "X" IN SECTION BOX:
--

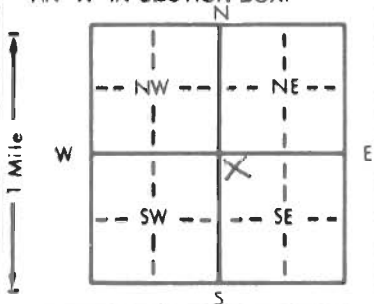

4 DEPTH OF COMPLETED WELL:	10.0	ft.	ELEVATION:	1052.4'
Depth(s) Groundwater Encountered	1. 0.0	ft.	2.	ft.
WELL'S STATIC WATER LEVEL	dry 0.0	ft. below land surface measured on mo/day/yr		
Pump test data: Well water was		ft. after	hours pumping	gpm
Est. Yield		gpm: Well water was	ft. after	hours pumping
Bore Hole Diameter	4	in. to	ft., and	in. to
WELL WATER TO BE USED AS:	5 Public water supply	8 Air conditioning	11 Injection well	
1 Domestic	3 Feedlot	6 Oil field water supply	9 Dewatering	12 Other (Specify below)
2 Irrigation	4 Industrial	7 Lawn and garden only	10 Observation well	
Was a chemical/bacteriological sample submitted to Department? Yes	No		If yes, mo/day/yr sample was submitted	
Water Well Disinfected? Yes	No			

5 TYPE OF BLANK CASING USED:	5 Wrought iron	8 Concrete tile	CASING JOINTS: Glued	Clamped
1 Steel	3 RMP (SR)	6 Asbestos-Cement	9 Other (specify below)	
2 PVC	4 ABS	7 Fiberglass	Welded	Threaded
Blank casing diameter	2	in. to	5.0	ft., Dia
Casing height above land surface	0.0	in., weight		lbs./ft. Wall thickness or gauge No. Sch. 40
TYPE OF SCREEN OR PERFORATION MATERIAL:	1 Steel	3 Stainless steel	5 Fiberglass	8 RMP (SR)
2 Brass	4 Galvanized steel	6 Concrete tile	9 ABS	12 None used (open hole)
SCREEN OR PERFORATION OPENINGS ARE:	1 Continuous slot	2 Mill slot	3 0.1"	5 Gauzed wrapped
2 Louvered shutter	4 Key punched	6 Wire wrapped	7 Torch cut	8 Saw cut
SCREEN-PERFORATED INTERVALS:	From	5.0	ft. to	10.0
GRAVEL PACK INTERVALS:	From	4.0	ft. to	10.0

6 GROUT MATERIAL:	1 Neat cement	2 Cement grout	3 Bentonite	4 Other
Grout Intervals:	From	0.0	ft. to	2.0
What is the nearest source of possible contamination:	1 Septic tank	4 Lateral lines	7 Pit privy	10 Livestock pens
2 Sewer lines	5 Cess pool	8 Sewage lagoon	11 Fuel storage	14 Abandoned water well
3 Watertight sewer lines	6 Seepage pit	9 Feedyard	12 Fertilizer storage	15 Oil well/Gas well
Direction from well?	Adjacent		13 Insecticide storage	16 Other (specify below)
			How many feet?	

FROM	TO	LITHOLOGIC LOG	FROM	TO	LITHOLOGIC LOG
0.0	3.0	Fill Crushed limestone and brown Silty Clay			
3.0	5.0	Undisturbed Sample Possible fill green mottled gray-rust sandy, silty clay w/sandstone fragments odiferous moist med. plastic			
5.0	8.0	Gray-brown silty clay w/odiferous moist medium plastic			
8.0	10.0	Undisturbed sample Gray-green mottled rust silty clay odiferous moist stiff plastic			
10.0		Termination of boring Boring dry upon completion			

7 CONTRACTOR'S OR LANDOWNER'S CERTIFICATION:	This water well was (1) constructed, (2) reconstructed, or (3) plugged under my jurisdiction and was completed on (mo/day/year) 8/14/87 and this record is true to the best of my knowledge and belief. Kansas Water Well Contractor's License No. 438A This Water Well Record was completed on (mo/day/yr) 8/13/87 under the business name of Kansas City Testing Labs by (signature) John [Signature]
--	---

INSTRUCTIONS: Use typewriter or ball point pen. PLEASE PRESS FIRMLY and PRINT clearly. Please fill in blanks, underline or circle the correct answers. Send top three copies to Kansas Department of Health and Environment, Bureau of Water Protection, Topeka, Kansas 66620-7320, Telephone: 913-862-9360. Send one to WATER WELL OWNER and retain one for your records.