

1 LOCATION OF WATER WELL:	Fraction	Section Number	Township Number	Range Number
County: <u>Johnson</u>	NW 1/4 NW 1/4 SE 1/4	24	T 12 S	R 24E EW

Distance and direction from nearest town or city street address of well if located within city?

11019 W. 75th Street Shawnee, Kansas

Well B-6

2 WATER WELL OWNER: Fina Oil & Chemical Co.


RR#, St. Address, Box #: 8350 N. Central Expressway

Board of Agriculture, Division of Water Resources

City, State, ZIP Code: Dallas, Texas 75206

Application Number:

3 LOCATE WELL'S LOCATION WITH AN "X" IN SECTION BOX:

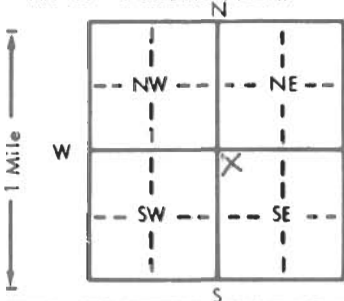

4 DEPTH OF COMPLETED WELL: 15.0 ft. ELEVATION: 1052.0'

Depth(s) Groundwater Encountered 1. 0.0 ft. 2. 0.0 ft. 3. 0.0 ft.

WELL'S STATIC WATER LEVEL 0.0 ft. below land surface measured on mo/day/yr

Pump test data: Well water was 0.0 ft. after 0.0 hours pumping 0.0 gpm

Est. Yield 0.0 gpm: Well water was 0.0 ft. after 0.0 hours pumping 0.0 gpm

Bore Hole Diameter 6 in. to 10.0 15.0 ft., and 0.0 in. to 0.0 ft.

WELL WATER TO BE USED AS: 5 Public water supply 8 Air conditioning 11 Injection well

1 Domestic 3 Feedlot 6 Oil field water supply 9 Dewatering 12 Other (Specify below)

2 Irrigation 4 Industrial 7 Lawn and garden only 10 Observation well

Was a chemical/bacteriological sample submitted to Department? Yes No; If yes, mo/day/yr sample was submitted

Water Well Disinfected? Yes No

5 TYPE OF BLANK CASING USED:

1 Steel 3 RMP (SR) 5 Wrought iron 8 Concrete tile CASING JOINTS: Glued Clamped

2 PVC 4 ABS 7 Fiberglass 9 Other (specify below) Welded

Blank casing diameter 2 in. to 10.0 ft., Dia 0.0 in. to 0.0 ft., Dia 0.0 in. to 0.0 ft.

Casing height above land surface 0.0 in., weight 0.0 lbs./ft. Wall thickness or gauge No. Sch. 40

TYPE OF SCREEN OR PERFORATION MATERIAL:

1 Steel 3 Stainless steel 5 Fiberglass 8 RMP (SR) 10 Asbestos-cement

2 Brass 4 Galvanized steel 6 Concrete tile 9 ABS 11 Other (specify)

SCREEN OR PERFORATION OPENINGS ARE:

1 Continuous slot 3 Mill slot 0.01" 5 Gauzed wrapped 8 Saw cut 11 None (open hole)

2 Louvered shutter 4 Key punched 7 Torch cut 9 Drilled holes

SCREEN-PERFORATED INTERVALS: From 10.0 ft. to 15.0 ft., From 0.0 ft. to 0.0 ft.

From 0.0 ft. to 0.0 ft., From 0.0 ft. to 0.0 ft.

GRAVEL PACK INTERVALS: From 4.0 ft. to 15.0 ft., From 0.0 ft. to 0.0 ft.

From 0.0 ft. to 0.0 ft., From 0.0 ft. to 0.0 ft.

6 GROUT MATERIAL:

1 Neat cement 2 Cement grout 3 Bentonite 4 Other

Grout Intervals: From 0.0 ft. to 2.0 ft., From 2.0 ft. to 4.0 ft., From 0.0 ft. to 0.0 ft.

What is the nearest source of possible contamination:

1 Septic tank 4 Lateral lines 7 Pit privy 10 Livestock pens 14 Abandoned water well

2 Sewer lines 5 Cess pool 8 Sewage lagoon 11 Fuel storage 15 Oil well/Gas well

3 Watertight sewer lines 6 Seepage pit 9 Feedyard 12 Fertilizer storage 16 Other (specify below)

Direction from well?

North east

How many feet?

45 feet

FROM	TO	LITHOLOGIC LOG	FROM	TO	LITHOLOGIC LOG
0.0	3.0	Fill Dark brown, red-brown silty clay and crushed limestone			
3.0	5.0	Undisturbed Sample Possible fill tan Sandy silty clay w/sandstone moist med. plastic			
5.0	8.0	Gray-green Sandy silty clay odiferous moist medium plastic			
8.0	10.0	Undisturbed Sample Gray-green mottled rust Sandy silty clay w/iron nodules odiferous moist stiff plastic			
10.0	13.0	Same material			
13.0	15.0	Undisturbed Sample Orange mottled black sandstone			
15.0		Termination of boring			
		Boring dry upon completion			

7 CONTRACTOR'S OR LANDOWNER'S CERTIFICATION: This water well was (1) constructed, (2) reconstructed, or (3) plugged under my jurisdiction and was completed on (mo/day/year) 8/4/87 and this record is true to the best of my knowledge and belief. Kansas

Water Well Contractor's License No. 438A This Water Well Record was completed on (mo/day/yr) 9/3/87

under the business name of Kansas City Testing Lab by (signature)

INSTRUCTIONS: Use typewriter or ball point pen. PLEASE PRESS FIRMLY and PRINT clearly. Please fill in blanks, underline or circle the correct answers. Send top three copies to Kansas Department of Health and Environment, Bureau of Water Protection, Topeka, Kansas 66620-7320, Telephone: 913-862-9360. Send one to WATER WELL OWNER and retain one for your records.

OFFICE USE ONLY

T

R

EW

SEC.

1/4

1/4

1/4