

1 LOCATION OF WATER WELL:	Fraction	Section Number	Township Number	Range Number
County: <u>Johnson</u>	NW 1/4 NW 1/4 SE 1/4	24	T 12S	R 24E EW

Distance and direction from nearest town or city street address of well if located within city?

11019 W. 75th Street, Shawnee, Kansas


Well B-5

2 WATER WELL OWNER:	Fina Oil & Chemical Co.
RR#, St. Address, Box # :	8350 N. Central Expressway
City, State, ZIP Code :	Dallas, Texas 75206

Board of Agriculture, Division of Water Resources

Application Number:

3 LOCATE WELL'S LOCATION WITH AN "X" IN SECTION BOX:
--

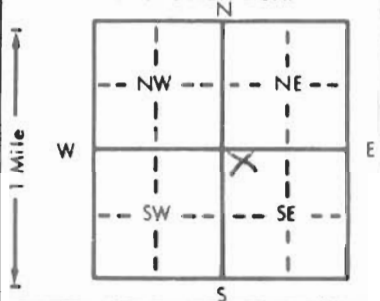

4 DEPTH OF COMPLETED WELL:	10.0	ft.	ELEVATION:	1052.2'
----------------------------	------	-----	------------	---------


WELL WATER TO BE USED AS: 5 Public water supply 8 Air conditioning 11 Injection well

1 Domestic 3 Feedlot 6 Oil field water supply 9 Dewatering 12 Other (Specify below)

2 Irrigation 4 Industrial 7 Lawn and garden only 10 Observation well

Was a chemical/bacteriological sample submitted to Department? Yes No; If yes, mo/day/yr sample was submittedWater Well Disinfected? Yes No

5 TYPE OF BLANK CASING USED:
------------------------------

- 1 Steel  
2 PVC  
3 RMP (SR)  
4 ABS

- 5 Wrought iron  
6 Asbestos-Cement  
7 Fiberglass

- 8 Concrete tile  
9 Other (specify below)


TYPE OF SCREEN OR PERFORATION MATERIAL:
---

- 1 Steel  
2 Brass  
3 Stainless steel  
4 Galvanized steel

- 5 Fiberglass  
6 Concrete tile

7 PVC

- 8 RMP (SR)  
9 ABS

10 Asbestos-cement

- 11 Other (specify)  
12 None used (open hole)

SCREEN OR PERFORATION OPENINGS ARE:
-------------------------------------

- 1 Continuous slot  
2 Louvered shutter  
3 Mill slot  
4 Key punched

- 5 Gauzed wrapped  
6 Wire wrapped  
7 Torch cut

- 8 Saw cut  
9 Drilled holes  
10 Other (specify)  
11 None (open hole)


6 GROUT MATERIAL:	1 Neat cement	2 Cement grout	3 Bentonite	4 Other
-------------------	---------------	----------------	-------------	---------

Grout intervals: From 0.0 ft. to 2.0 ft. From 2.0 ft. to 4.0 ft. From 4.0 ft. to 4.0 ft.

What is the nearest source of possible contamination:

- 1 Septic tank  
2 Sewer lines  
3 Watertight sewer lines  
4 Lateral lines  
5 Cess pool  
6 Seepage pit  
7 Pit privy  
8 Sewage lagoon  
9 Feedyard

- 10 Livestock pens  
11 Fuel storage  
12 Fertilizer storage  
13 Insecticide storage  
14 Abandoned water well  
15 Oil well/Gas well  
16 Other (specify below)

Direction from well?

Adjacent

How many feet?

FROM	TO	LITHOLOGIC LOG	FROM	TO	LITHOLOGIC LOG
0.0	3.0	Fill Silty clay and crushed limestone			
3.0	5.0	Undisturbed sample Possible fill			
		Dark gray mottled green sandy silty clay			
		odiferous moist medium soft plastic			
5.0	8.0	Possible fill Same material			
8.0	10.0	Undisturbed Sample Same material			
10.0		Termination of boring			
		Water level at 7.1' upon completion			

7 CONTRACTOR'S OR LANDOWNER'S CERTIFICATION: This water well was (1) constructed, (2) reconstructed, or (3) plugged under my jurisdiction and was completed on (mo/day/year) <u>8/4/87</u> and this record is true to the best of my knowledge and belief. Kansas Water Well Contractor's License No. <u>438</u> This Water Well Record was completed on (mo/day/year) <u>8/3/87</u> under the business name of <u>Kansas City Testing Labs</u> by (signature) <u>[Signature]</u>
---

INSTRUCTIONS: Use typewriter or ball point pen. PLEASE PRESS FIRMLY and PRINT clearly. Please fill in blanks, underline or circle the correct answers. Send one to Kansas Department of Health and Environment, Bureau of Water Protection, Topeka, Kansas 66620-7320, Telephone: 913-862-9360. Send one to WATER WELL OWNER and retain one for your records.