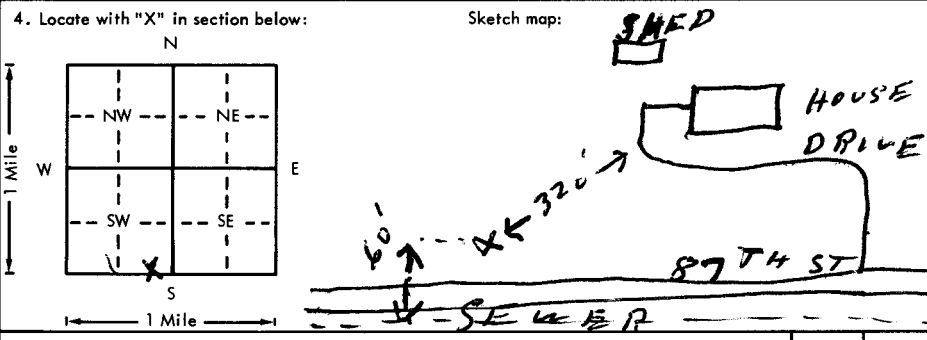


USE TYPEWRITER OR BALL  
POINT PEN-PRESS FIRMLY,  
PRINT CLEARLY.

WATER WELL RECORD  
KSA 82a-1201-1215

Kansas Department of Health and  
Environment-Division of Environment  
(Water well Contractors)  
Topeka, Kansas 66620

1. Location of well:	County <b>Johnson</b>	Fraction <b>SE 1/4 SE 1/4 SW 1/4</b>	Section number <b>28</b>	Township number <b>T 12S</b>	Range number <b>S R 24E</b>
2. Distance and direction from nearest town or city: <b>In city of Lenexa</b>		Owner of well: <b>Louis Stumpf</b>			
Street address of well location if in city: <b>14800 W. 87th St. Lenexa Kans. 66215</b>		R.R. or street: <b>14800 W. 87th St.</b>			
City, state, zip code: <b>Lenexa, Kans. 66215</b>					
4. Locate with "X" in section below: 		6. Bore hole dia. <b>8"</b> in. Completion date <b>10-13-75</b> Well depth <b>145'</b> ft. <b>dry hole</b>			
5. Type and color of material		7. <input checked="" type="checkbox"/> Cable tool <input type="checkbox"/> Rotary <input type="checkbox"/> Driven <input type="checkbox"/> Dug <input type="checkbox"/> Hollow rod <input type="checkbox"/> Jetted <input type="checkbox"/> Bored <input type="checkbox"/> Reverse rotary			
surface		8. Use: <input checked="" type="checkbox"/> Domestic <input type="checkbox"/> Public supply <input type="checkbox"/> Industry <input type="checkbox"/> Irrigation <input type="checkbox"/> Air conditioning <input type="checkbox"/> Stock <input type="checkbox"/> Lawn <input type="checkbox"/> Oil field water <input type="checkbox"/> Other			
Lime		9. Casing: Material <b>dry hole</b> Height: Above or below Threaded <input type="checkbox"/> Welded <input type="checkbox"/> Surface <input type="checkbox"/> in. RMP <input type="checkbox"/> PVC <input type="checkbox"/> Weight <input type="checkbox"/> lbs./ft. Dia. <input type="checkbox"/> in. to <input type="checkbox"/> ft. depth Wall Thickness: inches or Dia. <input type="checkbox"/> in. to <input type="checkbox"/> ft. depth gage No. <input type="checkbox"/>			
shale red & green		10. Screen: Manufacturer's name <b>dry hole</b>			
shale gray		Type <input type="checkbox"/> Dia. <input type="checkbox"/> Slot/gauze <input type="checkbox"/> Length <input type="checkbox"/> Set between <input type="checkbox"/> ft. and <input type="checkbox"/> ft. <input type="checkbox"/> ft. and <input type="checkbox"/> ft.			
lime		Gravel pack? <input type="checkbox"/> Size range of material <input type="checkbox"/>			
shale gray		11. Static water level: <b>dry hole</b> mo./day/yr. <input type="checkbox"/> ft. below land surface Date <input type="checkbox"/>			
lime		12. Pumping level below land surfaces: <b>dry hole</b> <input type="checkbox"/> ft. after <input type="checkbox"/> hrs. pumping <input type="checkbox"/> g.p.m. <input type="checkbox"/> ft. after <input type="checkbox"/> hrs. pumping <input type="checkbox"/> g.p.m. Estimated maximum yield <input type="checkbox"/> g.p.m.			
shale gray		13. Water sample submitted: <b>dry hole</b> mo./day/yr. <input type="checkbox"/> Yes <input type="checkbox"/> No Date <input type="checkbox"/>			
shale lime		14. Well head completion: <b>dry hole</b> <input type="checkbox"/> Pitless adapter <input type="checkbox"/> Inches above grade			
lime shale gray		15. Well grouted? <b>dry hole</b> With: <input type="checkbox"/> Neat cement <input type="checkbox"/> Bentonite <input type="checkbox"/> Concrete Depth: From <input type="checkbox"/> ft. to <input type="checkbox"/> ft.			
lime		16. Nearest source of possible contamination ft. <b>100</b> Direction <b>south</b> Type <b>sewer</b> Well disinfected upon completion? <input type="checkbox"/> Yes <input type="checkbox"/> No			
shale gray		17. Pump: <input type="checkbox"/> Not installed Manufacturer's name <b>dry hole</b> Model number <input type="checkbox"/> HP <input type="checkbox"/> Volts <input type="checkbox"/> Length of drop pipe <input type="checkbox"/> ft. capacity <input type="checkbox"/> g.p.m. Type: <input type="checkbox"/> Submersible <b>dry hole</b> <input type="checkbox"/> Turbine <input type="checkbox"/> Jet <input type="checkbox"/> Reciprocating <input type="checkbox"/> Centrifugal <input type="checkbox"/> Other			
lime TD					
(Use a second sheet if needed)					
18. Elevation: <b>958'</b> <b>968'</b>	19. Remarks: Customer aware of regulation and agrees to install concrete slab around casing X Hole plugged at 68' with rocks and shale and 3 sacks of cement. Hole plugged at 14' with rocks & shale & 3 sacks of cement & filled to surface with clay.		20. Water well contractor's certification: This well was drilled under my jurisdiction and this report is true to the best of my knowledge and belief. #240 <b>F. E. Young Drilling Co.</b> Business name <b>6355 Robinhood Ln.</b> License No. <input type="checkbox"/> Address <b>Merriam, Ks. 66203</b> Signed <b>F. E. Young</b> Date <b>12-3-75</b> Authorized representative		

Forward the white, blue and pink copies to the Department of Health and Environment

BR = 949

▽ =