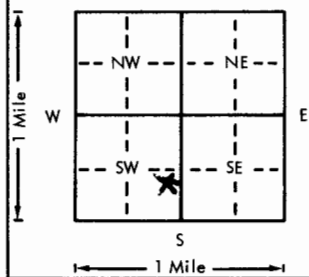


USE TYPEWRITER OR BALL  
POINT PEN-PRESS FIRMLY,  
PRINT CLEARLY.

WATER WELL RECORD  
KSA 82a-1201-1215

Kansas Department of Health and  
Environment-Division of Environment  
(Water well Contractors)  
Topeka, Kansas 66620

1. Location of well:		County <b>Johnson</b>	Fraction <b>SE 1/4 SW 1/4</b>	Section number <b>28</b>	Township number <b>T 12S</b>	Range number <b>S R 24E E/W</b>
2. Distance and direction from nearest town or city: Street address of well location if in city:		In city <b>Lenexa</b> <b>14800 W. 87th St.</b> <b>Lenexa, Kans 66215</b>		3. Owner of well: <b>Louis Stumpf</b> R.R. or street: <b>14800 W. 87th St.</b> City, state, zip code: <b>Lenexa, Kans. 66215</b>		
4. Locate with "X" in section below:		Sketch map:				6. Bore hole dia. <b>8"</b> in. Completion date <b>10-21-75</b> Well depth <b>170</b> ft. W.D. <b>170'</b>
						7. <input checked="" type="checkbox"/> Cable tool <input type="checkbox"/> Rotary <input type="checkbox"/> Driven <input type="checkbox"/> Dug <input type="checkbox"/> Hollow rod <input type="checkbox"/> Jetted <input type="checkbox"/> Bored <input type="checkbox"/> Reverse rotary
5. Type and color of material		From		To		8. Use: <input checked="" type="checkbox"/> Domestic <input type="checkbox"/> Public supply <input type="checkbox"/> Industry <input type="checkbox"/> Irrigation <input type="checkbox"/> Air conditioning <input type="checkbox"/> Stock <input type="checkbox"/> Lawn <input type="checkbox"/> Oil field water <input type="checkbox"/> Other
Topsoil		0		2		9. Casing: Material <input type="checkbox"/> Height: Above or below Threaded <input type="checkbox"/> Welded <input type="checkbox"/> Surface <input type="checkbox"/> in. RMP <input type="checkbox"/> PVC <input type="checkbox"/> Weight <input type="checkbox"/> lbs./ft. Dia. <input type="checkbox"/> in. to <input type="checkbox"/> ft. depth Wall Thickness: inches or Dia. <input type="checkbox"/> in. to <input type="checkbox"/> ft. depth gage No. <input type="checkbox"/>
sandstone brown		2		12		10. Screen: Manufacturer's name <input type="checkbox"/> <b>dry hole</b> Type <input type="checkbox"/> Dia. <input type="checkbox"/> Slot/gauze <input type="checkbox"/> Length <input type="checkbox"/> Set between <input type="checkbox"/> ft. and <input type="checkbox"/> ft. <input type="checkbox"/> ft. and <input type="checkbox"/> ft.
lime		12		28		Gravel pack? <input type="checkbox"/> Size range of material <input type="checkbox"/>
shale gray		28		38		11. Static water level: <b>dry hole</b> mo./day/yr. <input type="checkbox"/> ft. below land surface Date <input type="checkbox"/>
lime		38		52		12. Pumping level below land surfaces: <input type="checkbox"/> ft. after <input type="checkbox"/> hrs. pumping <input type="checkbox"/> g.p.m. <input type="checkbox"/> ft. after <input type="checkbox"/> hrs. pumping <input type="checkbox"/> g.p.m. Estimated maximum yield <b>dry hole</b> g.p.m.
shale red & green		52		72		13. Water sample submitted: <input type="checkbox"/> mo./day/yr. <input type="checkbox"/> Yes <input type="checkbox"/> No Date <b>dry hole</b>
lime		72		76		14. Well head completion: <b>dry hole</b> <input type="checkbox"/> Pitless adapter <input type="checkbox"/> Inches above grade
shale gray		76		80		15. Well grouted? <b>dry hole</b> With: <input type="checkbox"/> Neat cement <input type="checkbox"/> Bentonite <input type="checkbox"/> Concrete Depth: From <input type="checkbox"/> ft. to <input type="checkbox"/> ft.
lime		80		85		16. Nearest source of possible contamination: ft. <b>460</b> Direction <b>S</b> Type <b>septic tank</b> Well disinfected upon completion? <input type="checkbox"/> Yes <input type="checkbox"/> No
shale gray		85		88		17. Pump: <b>none</b> <input type="checkbox"/> Not installed Manufacturer's name <input type="checkbox"/> Model number <input type="checkbox"/> HP <input type="checkbox"/> Volts <input type="checkbox"/> Length of drop pipe <input type="checkbox"/> ft. capacity <input type="checkbox"/> g.p.m. Type: <input type="checkbox"/> Submersible <input type="checkbox"/> Turbine <input type="checkbox"/> Jet <input type="checkbox"/> Reciprocating <input type="checkbox"/> Centrifugal <input type="checkbox"/> Other
lime		88		93		
shale gray		93		102		
lime		102		128		
shale Dk. shale TD		128		170		
(Use a second sheet if needed)						
18. Elevation: <b>980</b> Topography: <input checked="" type="checkbox"/> Hill <input type="checkbox"/> Slope <input type="checkbox"/> Upland <input type="checkbox"/> Valley		19. Remarks: <b>Plugged at 128' with rocks and shale and 3 sacks of cement. Plugged at 28' with rocks &amp; shale &amp; 3 sacks of cement &amp; filled to surface with clay.</b>				20. Water well contractor's certification: This well was drilled under my jurisdiction and this report is true to the best of my knowledge and belief. <b>Young Drilling Co. 240</b> Business name <b>6555 Robinhood Ln</b> License No. <b>203</b> Address <b>Merriam, Kans. 66203</b> Signed <b>F.H. Young</b> Date <b>12-4-75</b> Authorized representative

Forward the white, blue and pink copies to the Department of Health and Environment

Form WWC-5