

CORRECTION(S) TO WATER WELL RECORD (Form WWC-5)

MW 6

(to rectify lacking or incorrect information)

LOCATION OF WATER WELL: County: <u>Johnson</u>	Fraction <u> </u> $\frac{1}{4}$ <u>SE</u> $\frac{1}{4}$ <u>NE</u> $\frac{1}{4}$ <u>SW</u> $\frac{1}{4}$	Section <u>11</u>	Township <u>T 12 S</u>	Range <u>R 24</u> <input checked="" type="checkbox"/> E <input type="checkbox"/> W
--	---	----------------------	---------------------------	---

Owner: Coastal Mart Inc

Location was listed as:

Sec. 11 T 12 S R 24 E W

Fraction: NE NE NE

Location changed to:

Sec. 11 T 12 S R 24 E W

Fraction: SE NE SW

Other changes: Initial statements: Recived plugging record with note from driller that the site map and our quarter sections on the completion form and in the database did not match.

Changed to: _____

Comments: _____

Verification method: Used site map from driller, aerial image, well completion and plugging forms.

initials: df date: 04/22/2014


Submitted by: Kansas Geological Survey, Data Resources Library, 1930 Constant Ave., Lawrence, KS 66047-3726
to: Kansas Dept of Health & Environment, Bureau of Water, 1000 SW Jackson, Suite 420, Topeka, KS 66612-1367.

WATER WELL RECORD Form WWC-5 KSA 82a-1212

1 LOCATION OF WATER WELL: Fraction NE 1/4 NE 1/4 NE 1/4 Section Number 11 Township Number T 12 S Range Number R 24 **EW**
 County: JOHNSON

Distance and direction from nearest town or city street address of well if located within city?
 6000 NIEMAN ROAD SHAWNEE, KS. MW#6

2 WATER WELL OWNER: COASTAL MART, INC C/O DEBBIE HARRIS
 RR#, St. Address, Box #: 9 GREENWAY PLAZA SUITE 2810 Board of Agriculture, Division of Water Resources
 City, State, ZIP Code: HOUSTON, TX 77046 Application Number:

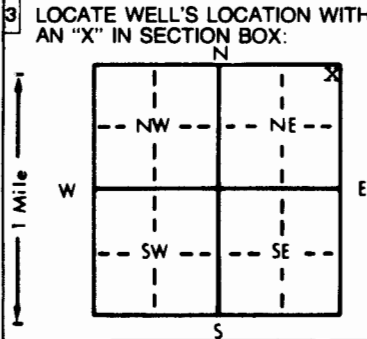

4 DEPTH OF COMPLETED WELL: 11.5 ft. ELEVATION:
 Depth(s) Groundwater Encountered 1. ft. 2. ft. 3. ft.
 WELL'S STATIC WATER LEVEL ft. below land surface measured on mo/day/yr
 Pump test data: Well water was ft. after hours pumping gpm
 Est. Yield gpm: Well water was ft. after hours pumping gpm
 Bore Hole Diameter: 7 7/8 in. to 11.5 ft., and in. to ft.
 WELL WATER TO BE USED AS: 5 Public water supply 8 Air conditioning 11 Injection well
 1 Domestic 3 Feedlot 6 Oil field water supply 9 Dewatering 12 Other (Specify below)
 2 Irrigation 4 Industrial 7 Lawn and garden only 10 Monitoring well
 Was a chemical/bacteriological sample submitted to Department? Yes No ; If yes, mo/day/yr sample was sub-
 mitted Water Well Disinfected? Yes No

5 TYPE OF BLANK CASING USED: 5 Wrought iron 8 Concrete tile CASING JOINTS: Glued Clamped
 1 Steel 3 RMP (SR) 6 Asbestos-Cement 9 Other (specify below) Welded
 2 PVC X 4 ABS 7 Fiberglass X Threaded.
 Blank casing diameter 2 in. to 5 ft., Dia in. to ft., Dia in. to ft.
 Casing height above land surface 0 in., weight sched 40 lbs./ft. Wall thickness or gauge No.
 TYPE OF SCREEN OR PERFORATION MATERIAL: X7 PVC 10 Asbestos-cement
 1 Steel 3 Stainless steel 5 Fiberglass 8 RMP (SR) 11 Other (specify)
 2 Brass 4 Galvanized steel 6 Concrete tile 9 ABS 12 None used (open hole)
 SCREEN OR PERFORATION OPENINGS ARE: 5 Gauzed wrapped 8 Saw cut 11 None (open hole)
 1 Continuous slot X3 Mill slot 0.10 6 Wire wrapped 9 Drilled holes
 2 Louvered shutter 4 Key punched 7 Torch cut 10 Other (specify)
 SCREEN-PERFORATED INTERVALS: From 11.5 ft. to 5 ft., From ft. to ft.
 From ft. to ft., From ft. to ft.
 GRAVEL PACK INTERVALS: From 11.5 ft. to 4 ft., From ft. to ft.
 From ft. to ft., From ft. to ft.

6 GROUT MATERIAL: 1 Neat cement X 2 Cement grout 4 X 3 Bentonite 2.5 4 Other
 Grout Intervals: From 2.5 ft. to -0.03 ft., From 4 ft. to 2.5 ft., From ft. to ft.
 What is the nearest source of possible contamination:
 1 Septic tank 4 Lateral lines 7 Pit privy 10 Livestock pens 14 Abandoned water well
 2 Sewer lines 5 Cess pool 8 Sewage lagoon 11 Fuel storage 15 Oil well/Gas well
 X3 Watertight sewer lines 6 Seepage pit 9 Feedyard 12 Fertilizer storage 16 Other (specify below)
 13 Insecticide storage
 Direction from well? east How many feet? 12

FROM	TO	LITHOLOGIC LOG	FROM	TO	PLUGGING INTERVALS
0	6"	ASPHALT			
6"	2	TOPSOIL			
2	7	BRN SILTY CLAY			
7	10.5	BRN TAN SILTY CLAY			
10.5	11	LIMESTONE			

7 CONTRACTOR'S OR LANDOWNER'S CERTIFICATION: This water well was (1) constructed, (2) reconstructed, or (3) plugged under my jurisdiction and was completed on (mo/day/year) 1-29-98 575 and this record is true to the best of my knowledge and belief. Kansas Water Well Contractor's License No. This Water Well Record was completed on (mo/day/yr) 2-12-98 under the business name of KURTZ ENVIRONMENTAL SERVICE by (signature)

OFFICE USE ONLY T R EW SEC 1/4 1/4 1/4 1/4

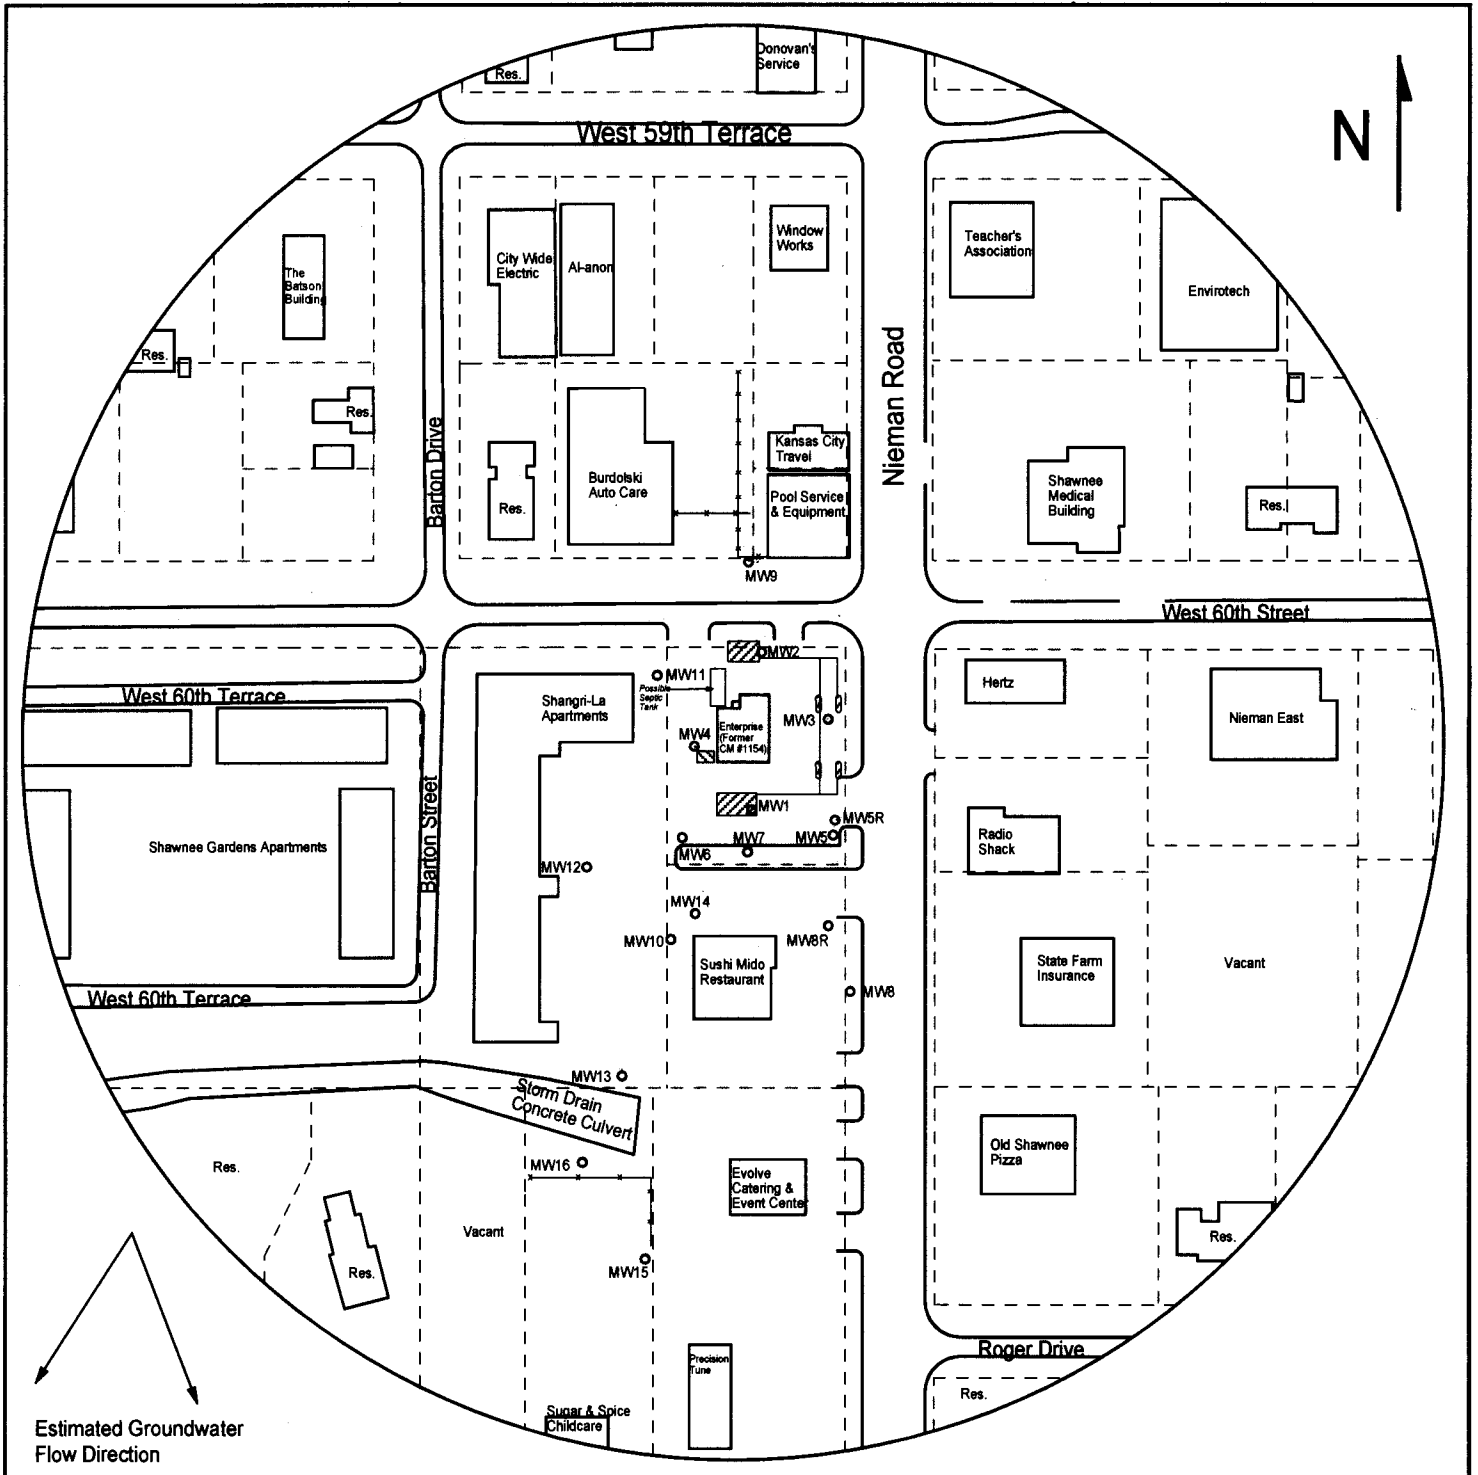


FIGURE 1 - 500 FT RADIUS AREA BASE MAP



1311 E 25th St., Suite B 785-841-8707 office
 Lawrence, KS 66046 785-865-4282 fax

PROJECT:

Coastal Mart #1154
 6000 Nieman Rd.
 Shawnee, KS
 KDHE ID: U4-046-00099
 Date: 10/31/13 & 11/19/13



LEGEND

- Approximate Location of Former UST Basin, Pump Islands & Product Lines
- Approximate Location of Former Waste Oil Tank
- Existing Monitoring Well
- Plugged/Destroyed Monitoring Well
- Approximate Location of Property Line

Figures exhibited within this report are only to be used within the context of this report. Placement of property lines, wells, structures, and roads is based on the available information from county appraiser maps, surveys, site visits, and/or previous vendor reports and should be considered approximate.