

CORRECTION(S) TO WATER WELL RECORD (Form WWC-5)
(to rectify lacking or incorrect information)

MW 10

LOCATION OF WATER WELL: County: <u>Johnson</u>	Fraction <u> </u> ¼ <u>SE</u> ¼ <u>NE</u> ¼ <u>SW</u> ¼	Section <u>11</u>	Township <u>T 12 S</u>	Range <u>R 24</u> <input checked="" type="checkbox"/> E <input type="checkbox"/> W
--	---	----------------------	---------------------------	---

Owner: Coastal Mart Inc

Location was listed as:

Sec. 11 T 12 S R 24 E W

Fraction: NE NE NE

Location changed to:

Sec. 11 T 12 S R 24 E W

Fraction: SE NE SW

Other changes: Initial statements: Recived plugging record with note from driller that the site map and our quarter sections on the completion form and in the database did not match.

Changed to: _____

Comments: _____

Verification method: Used site map from driller, aerial image, well completion and plugging forms.

initials: df date: 04/22/2014

Submitted by: Kansas Geological Survey, Data Resources Library, 1930 Constant Ave., Lawrence, KS 66047-3726
to: Kansas Dept of Health & Environment, Bureau of Water, 1000 SW Jackson, Suite 420, Topeka, KS 66612-1367.

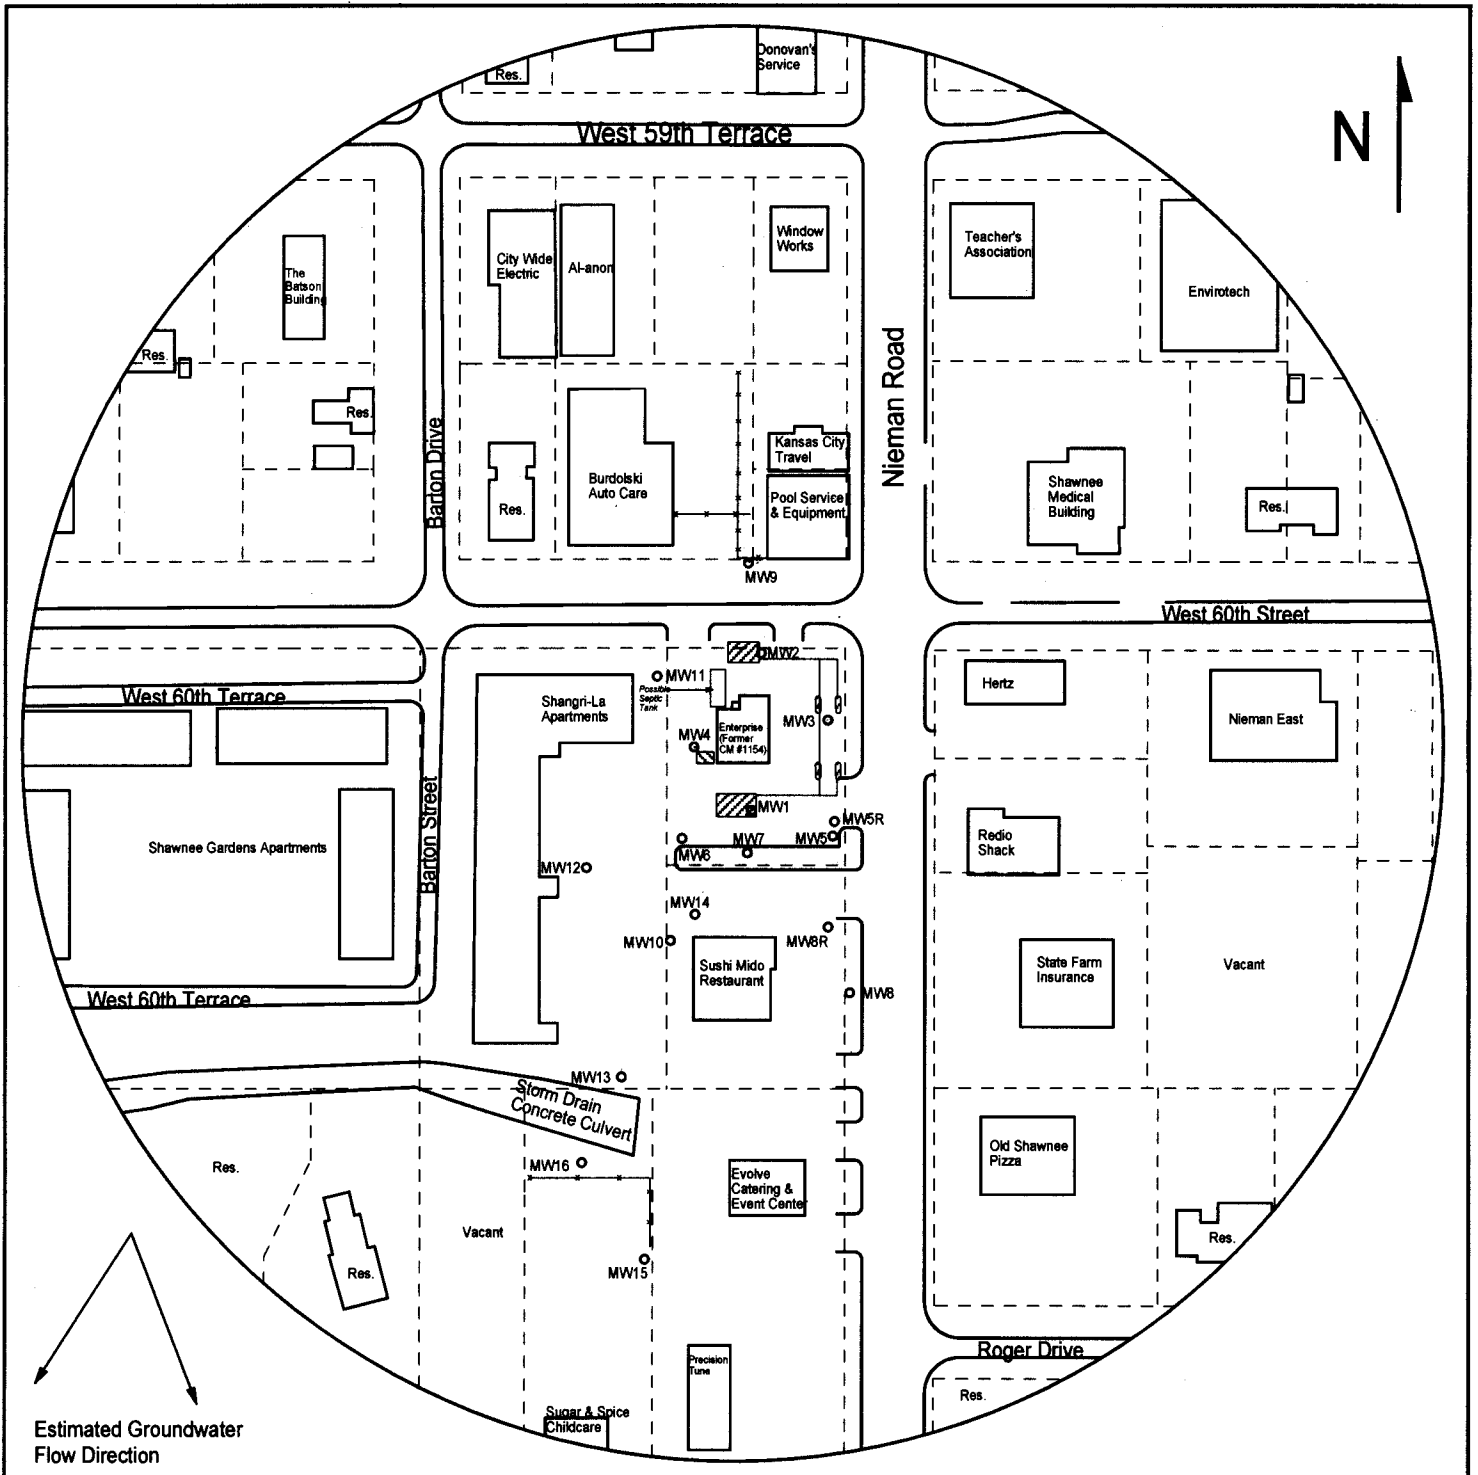



FIGURE 1 - 500 FT RADIUS AREA BASE MAP



1311 E 25th St., Suite B 785-841-8707 office
 Lawrence, KS 66046 785-865-4282 fax

PROJECT:

Coastal Mart #1154
 6000 Nieman Rd.
 Shawnee, KS
 KDHE ID: U4-046-00099
 Date: 10/31/13 & 11/19/13

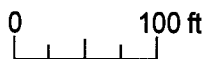

LEGEND

- Approximate Location of Former UST Basin, Pump Islands & Product Lines
- Approximate Location of Former Waste Oil Tank
- Existing Monitoring Well
- Plugged/Destroyed Monitoring Well
- Approximate Location of Property Line

Figures exhibited within this report are only to be used within the context of this report. Placement of property lines, wells, structures, and roads is based on the available information from county appraiser maps, surveys, site visits, and/or previous vendor reports and should be considered approximate.