

Clark
MW-1


1 LOCATION OF WATER WELL: County: **JOHNSON** Fraction: **SE 1/4 SW 1/4 SE 1/4** Section Number: **11** Township Number: **T 12 S** Range Number: **R 24 E/W**

Distance and direction from nearest town or city street address of well if located within city?

10900 W. 63rd STR., SHAWNEE, KS.

2 WATER WELL OWNER: **Clark Station**
 RR#, St. Address, Box #: **10900 W. 63rd**
 City, State, ZIP Code: **Shawnee, KS**
 Board of Agriculture, Division of Water Resources
 Application Number:

3 LOCATE WELL'S LOCATION WITH AN "X" IN SECTION BOX:

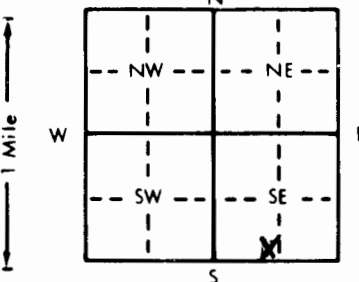

4 DEPTH OF COMPLETED WELL: ~~20~~ **19.5** ft. ELEVATION:
 Depth(s) Groundwater Encountered 1. **13.0** ft. 2. — ft. 3. — ft.
 WELL'S STATIC WATER LEVEL **7.99** ft. below land surface measured on mo/day/yr **NA**
 Pump test data: Well water was — ft. after — hours pumping — gpm
 Est. Yield — gpm: Well water was — ft. after — hours pumping — gpm
 Bore Hole Diameter: **8.3** in. to **20 feet** ft., and — in. to — ft.
 WELL WATER TO BE USED AS:
 5 Public water supply 8 Air conditioning 11 Injection well
 1 Domestic 3 Feedlot 6 Oil field water supply 9 Dewatering 12 Other (Specify below)
 2 Irrigation 4 Industrial 7 Lawn and garden only Monitoring well **mw-1**
 Was a chemical/bacteriological sample submitted to Department? Yes. No. If yes, mo/day/yr sample was submitted
 Water Well Disinfected? Yes No

5 TYPE OF CASING USED:
 1 Steel 3 RMP (SR) 5 Wrought iron 8 Concrete tile CASING JOINTS: Glued Clamped
 PVC 4 ABS 6 Asbestos-Cement 9 Other (specify below) Welded
 7 Fiberglass Threaded

Blank casing diameter **2** in. to **10** ft., Dia. — in. to — ft., Dia. — in. to — ft.
 Casing height above land surface **FLUSH** in., weight — lbs./ft. Wall thickness or gauge No. **SCH 40**

TYPE OF SCREEN OR PERFORATION MATERIAL:
 1 Steel 3 Stainless steel 5 Fiberglass 8 RMP (SR) 10 Asbestos-cement
 2 Brass 4 Galvanized steel 6 Concrete tile 9 ABS 11 Other (specify)
 12 None used (open hole)

SCREEN OR PERFORATION OPENINGS ARE:
 1 Continuous slot Mill slot 5 Gauzed wrapped 8 Saw cut 11 None (open hole)
 2 Louvered shutter 4 Key punched 6 Wire wrapped 9 Drilled holes
 7 Torch cut 10 Other (specify)

SCREEN-PERFORATED INTERVALS: From **10** ft. to ~~20~~ **19.5** ft., From — ft. to — ft.
 From — ft. to — ft., From — ft. to — ft.
 GRAVEL PACK INTERVALS: From **7** ft. to ~~20~~ **19.5** ft., From — ft. to — ft.
 From — ft. to — ft., From — ft. to — ft.

6 GROUT MATERIAL: 1 Neat cement 2 Cement grout Bentonite 4 Other
 Grout Intervals: From **0** ft. to **2** ft. From **2** ft. to **7** ft., From — ft. to — ft.

What is the nearest source of possible contamination:
 1 Septic tank 4 Lateral lines 7 Pit privy 10 Livestock pens 14 Abandoned water well
 2 Sewer lines 5 Cess pool 8 Sewage lagoon 11 Fuel storage 15 Oil well/Gas well
 3 Watertight sewer lines 6 Seepage pit 9 Feedyard 12 Fertilizer storage 16 Other (specify below)
 13 Insecticide storage **CONTAMINATED SIDE**

Direction from well? How many feet?

FROM	TO	LITHOLOGIC LOG	FROM	TO	PLUGGING INTERVALS
0	0.5	CONCRETE			
0.5	5	Silt, dk BROWN			
5	9	Clay, GRAY			
9	20	CLAY, DK. BROWN			
	20	TD.			

7 CONTRACTOR'S OR LANDOWNER'S CERTIFICATION: This water well was constructed, (2) reconstructed, or (3) plugged under my jurisdiction and was completed on (mo/day/year) **12/15/97** and this record is true to the best of my knowledge and belief. Kansas Water Well Contractor's License No. **SBS** This Water Well Record was completed on (mo/day/yr) **2/4/98** under the business name of **ASSOC. ENVIRONMENTAL INC.** by (signature) *[Signature]*