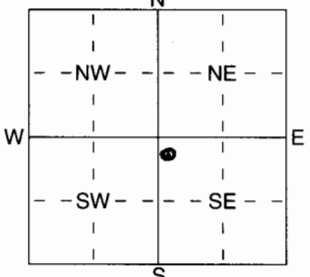


1 LOCATION OF WATER WELL: County: Johnson	Fraction NW 1/4 NW 1/4 SE 1/4	Section Number 03	Township Number T 12 S	Range Number R 24 EW
---	---	-----------------------------	----------------------------------	---------------------------------------

Distance and direction from nearest town or city street address of well if located within city?
7120 State Line Road, Prairie Village, Ks.

2 WATER WELL OWNER: **Shell Oil Products, U.S.**
 RR#, St. Address, Box #: **308 Wilcox, #101**
 City, State, ZIP Code: **Castle Rock, Colo 80104**
 Board of Agriculture, Division of Water Resources
 Application Number:

3 LOCATE WELL'S LOCATION WITH AN "X" IN SECTION BOX:


4 DEPTH OF COMPLETED WELL **15'6"** ft. ELEVATION:
 Depth(s) Groundwater Encountered 1 **10'** ft. 2 ft. 3 ft.
 WELL'S STATIC WATER LEVEL **5.92** ft. below land surface measured on mo/day/yr **8-4-04**
 Pump test data: Well water was ft. after hours pumping gpm
 Est. Yield gpm: Well water was ft. after hours pumping gpm
 WELL TO BE USED AS: 5 Public water supply 8 Air conditioning 11 Injection well
 1 Domestic 3 Feedlot 6 Oil field water supply 9 Dewatering 12 Other (Specify below)
 2 Irrigation 4 Industrial 7 Domestic (lawn & garden) **10 Monitoring well**

Was a chemical/bacteriological sample submitted to Department? Yes No **X**; If yes, mo/day/yr sample was submitted
 Water Well Disinfected? Yes **(No)**

5 TYPE OF BLANK CASING USED:
 1 Steel 3 RMP (SR) 5 Wrought iron 8 Concrete tile CASING JOINTS: Glued Clamped
2 PVC 4 ABS 6 Asbestos-Cement 9 Other (specify below) Welded
 7 Fiberglass Threaded **X**

Blank casing diameter **2.375** in. to **5'** ft., Dia in. to ft., Dia in. to ft.
 Casing height above land surface **Flush Mt.** in., weight lbs./ft. Wall thickness or gauge No. **sch 40**

TYPE OF SCREEN OR PERFORATION MATERIAL:
 1 Steel 3 Stainless Steel 5 Fiberglass 8 RMP (SR) 10 Asbestos-Cement
 2 Brass 4 Galvanized Steel 6 Concrete tile 9 ABS 11 Other (Specify)
 12 None used (open hole)

SCREEN OR PERFORATION OPENINGS ARE:
 1 Continuous slot 3 Mill slot 5 Gauzed wrapped 8 Saw cut 11 None (open hole)
 2 Louvered shutter 4 Key punched 6 Wire wrapped 9 Drilled holes
 7 Torch cut 10 Other (specify) ft.

SCREEN-PERFORATED INTERVALS: From **15'** ft. to **5'** ft., From ft. to ft.
 From ft. to ft., From ft. to ft.
 GRAVEL PACK INTERVALS: From **15'6"** ft. to **4'** ft., From ft. to ft.
 From ft. to ft., From ft. to ft.

6 GROUT MATERIAL: 1 Neat cement 2 Cement grout **3 Bentonite** **4 Other Concrete**
 Grout Intervals: From **4'** to **2'** ft., From **2'** to **0'** ft., From ft. to ft.

What is the nearest source of possible contamination:
 1 Septic tank 4 Lateral lines 7 Pit privy **10 Livestock pens** 14 Abandoned water well
 2 Sewer lines 5 Cess pool 8 Sewage lagoon **11 Fuel storage** 15 Oil well/Gas well
 3 Watertight sewer lines 6 Seepage pit 9 Feedyard 12 Fertilizer storage 16 Other (specify below)
 13 Insecticide storage
 Direction from well? **North** How many feet? **90'**

FROM	TO	LITHOLOGIC LOG	FROM	TO	PLUGGING INTERVALS
0	1.0	Asphalt			
1.0	8.0	Brn-lt Brn clay w/iron oxide staining fum, moist			RECEIVED
8.0	13.0	Gray Brn to Brn Gray clay w/iron oxide staining and mottling, moist, fum			AUG 31 2004
13.0	15.6	Red Brn clay, moist, fums stiff			BUREAU OF WATER
					F.M. OK'd by D. Taylor

7 CONTRACTOR'S OR LANDOWNER'S CERTIFICATION: This water well was (1) constructed, (2) reconstructed, or (3) plugged under my jurisdiction and was completed on (mo/day/year) **9-30-04** and this record is true to the best of my knowledge and belief. Kansas Water Well Contractor's Licence No **732** This Water Well Record was completed on (mo/day/yr) **8-23-04** under the business name of **GB Env. Service + Supply** by (signature) **James Becker**

INSTRUCTIONS: Use typewriter or ball point pen. PLEASE PRESS FIRMLY and PRINT clearly. Please fill in blanks, underline or circle the correct answers. Send top three copies to Kansas Department of Health and Environment, Bureau of Water, Geology Section, 1000 SW Jackson St., Suite 420, Topeka, Kansas 66612-1367. Telephone 785-296-5522. Send one to WATER WELL OWNER and retain one for your records. Fee of \$5.00 for each constructed well.