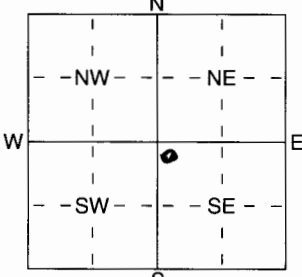


1 LOCATION OF WATER WELL: Fraction NW 1/4 NW 1/4 SE 1/4 Section Number 23 Township Number T 12 S Range Number R 24 EW
 County: Johnson

Distance and direction from nearest town or city street address of well if located within city?
7720 State Line Road; Prairie Village, Ks.

2 WATER WELL OWNER: Shell Oil Products, U.S.
 RR#, St. Address, Box #: 308 Wilcox #101 Board of Agriculture, Division of Water Resources
 City, State, ZIP Code: Castle Rock, Colo 80104 Application Number: _____

3 LOCATE WELL'S LOCATION WITH AN "X" IN SECTION BOX:  DEPTH OF COMPLETED WELL: 15' ft. ELEVATION: _____
 Depth(s) Groundwater Encountered: 1 8' ft. 2 _____ ft. 3 _____ ft.
 WELL'S STATIC WATER LEVEL: 4.93 ft. below land surface measured on mo/day/yr: 8-4-04
 Pump test data: Well water was _____ ft. after _____ hours pumping _____ gpm
 Est. Yield _____ gpm: Well water was _____ ft. after _____ hours pumping _____ gpm
 WELL WATER TO BE USED AS: 5 Public water supply 8 Air conditioning 11 Injection well
 1 Domestic 3 Feedlot 6 Oil field water supply 9 Dewatering 12 Other (Specify below)
 2 Irrigation 4 Industrial 7 Domestic (lawn & garden) 10 Monitoring well
 Was a chemical/bacteriological sample submitted to Department? Yes _____ No X; If yes, mo/day/yrs sample was submitted
 Water Well Disinfected? Yes _____ No (No)

5 TYPE OF BLANK CASING USED: 1 Steel 3 RMP (SR) 5 Wrought iron 8 Concrete tile CASING JOINTS: Glued _____ Clamped _____
2 PVC 4 ABS 6 Asbestos-Cement 9 Other (specify below) Welded _____
 Blank casing diameter: 2.375 in. to 5 ft., Dia _____ in. to _____ ft., Dia _____ in. to _____ ft.
 Casing height above land surface: Fluoh Mt. in., weight _____ lbs./ft. Wall thickness or gauge No. Sub 40
 TYPE OF SCREEN OR PERFORATION MATERIAL: 7 PVC 10 Asbestos-Cement
 1 Steel 3 Stainless Steel 5 Fiberglass 8 RMP (SR) 11 Other (Specify) _____
 2 Brass 4 Galvanized Steel 6 Concrete tile 9 ABS 12 None used (open hole)
 SCREEN OR PERFORATION OPENINGS ARE: 5 Gauzed wrapped 8 Saw cut 11 None (open hole)
 1 Continuous slot 3 Mill slot 6 Wire wrapped 9 Drilled holes
 2 Louvered shutter 4 Key punched 7 Torch cut 10 Other (specify) _____ ft.
 SCREEN-PERFORATED INTERVALS: From 15' ft. to 9' ft., From _____ ft. to _____ ft.
 GRAVEL PACK INTERVALS: From 15' ft. to 4' ft., From _____ ft. to _____ ft.

6 GROUT MATERIAL: 1 Neat cement 2 Cement grout 3 Bentonite 4 Other: Concrete
 Grout Intervals: From 4' ft. to 2' ft., From 2' ft. to Surface ft., From _____ ft. to _____ ft.
 What is the nearest source of possible contamination:
 1 Septic tank 4 Lateral lines 7 Pit privy 11 Fuel storage 14 Abandoned water well
 2 Sewer lines 5 Cess pool 8 Sewage lagoon 12 Fertilizer storage 15 Oil well/Gas well
 3 Watertight sewer lines 6 Seepage pit 9 Feedyard 13 Insecticide storage 16 Other (specify below) _____
 Direction from well? West How many feet? 25'

FROM	TO	LITHOLOGIC LOG	FROM	TO	PLUGGING INTERVALS
0	1.0	Asphalt over ls. & gravel			
1.00	3.00	Black clay, moist, firm			
3.0	15.0	olive green - gray mottled clay w/ iron oxides staining, firm			

RECEIVED
 AUG 31 2004
 BUREAU OF WATER
 F.M. OK'd by D. Taylor

7 CONTRACTOR'S OR LANDOWNER'S CERTIFICATION: This water well was (1) constructed (2) reconstructed, or (3) plugged under my jurisdiction and was completed on (mo/day/year) 7-28-04 and this record is true to the best of my knowledge and belief. Kansas Water Well Contractor's Licence No. 732 This Water Well Record was completed on (mo/day/yr) 8-23-04 under the business name of G.Benv. Service & Supply by (signature) James Baker