


1 LOCATION OF WATER WELL: County: Johnson Fraction: NE 1/4 SE 1/4 SE 1/4 Section Number: 4 Township Number: T 125 S Range Number: R 24E EW

Distance and direction from nearest town or city street address of well if located within city?
East of 3500 5300 Summit Court Shawnee, KS, Appx. 30 feet.

2 WATER WELL OWNER: Magellan Pipeline Company Attn: Alan Johns
 RR#, St. Address, Box #: One Williams Center, MO 30-7 Board of Agriculture, Division of Water Resources
 City, State, ZIP Code: Tulsa, OK 74172 Application Number:

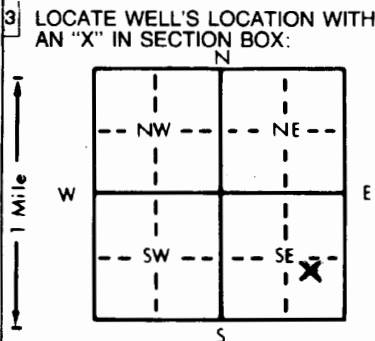

4 DEPTH OF COMPLETED WELL: 26.5 ft. ELEVATION: ~926 ft. AMSL
 Depth(s) Groundwater Encountered 1. None ft. 2. _____ ft. 3. _____ ft.
 WELL'S STATIC WATER LEVEL _____ ft. below land surface measured on mo/day/yr _____
 Pump test data: Well water was _____ ft. after _____ hours pumping _____ gpm
 Est. Yield _____ gpm: Well water was _____ ft. after _____ hours pumping _____ gpm
 Bore Hole Diameter _____ in. to _____ ft., and _____ in. to _____ ft.
 WELL WATER TO BE USED AS:
 1 Domestic 3 Feedlot 6 Oil field water supply 9 Dewatering 11 Injection well
 2 Irrigation 4 Industrial 7 Lawn and garden only 10 Monitoring well
 Was a chemical/bacteriological sample submitted to Department? Yes _____ No X; If yes, mo/day/yr sample was submitted _____
 Water Well Disinfected? Yes _____ No X

5 TYPE OF CASING USED:
 1 Steel 3 RMP (SR) 5 Wrought iron 8 Concrete tile CASING JOINTS: Glued _____ Clamped _____
2 PVC 4 ABS 6 Asbestos-Cement 9 Other (specify below) Welded _____
 7 Fiberglass Threaded
 Blank casing diameter 2" ST in. to 21 ft., Dia _____ in. to _____ ft., Dia _____ in. to _____ ft.
 Casing height above land surface 0 in., weight _____ lbs./ft. Wall thickness or gauge No. sch. 40
 TYPE OF SCREEN OR PERFORATION MATERIAL:
 1 Steel 3 Stainless steel 5 Fiberglass 8 RMP (SR) 10 Asbestos-cement 11 Other (specify) _____
 2 Brass 4 Galvanized steel 6 Concrete tile 9 ABS 12 None used (open hole)
 SCREEN OR PERFORATION OPENINGS ARE:
 1 Continuous slot 3 Mill slot 5 Gauzed wrapped 8 Saw cut 11 None (open hole)
 2 Louvered shutter 4 Key punched 6 Wire wrapped 9 Drilled holes
 7 Torch cut 10 Other (specify) _____
 SCREEN-PERFORATED INTERVALS: From 26 ft. to 21 ft., From _____ ft. to _____ ft.
 From _____ ft. to _____ ft., From _____ ft. to _____ ft.
 GRAVEL PACK INTERVALS: From 26.5 ft. to 18 ft., From _____ ft. to _____ ft.
 From _____ ft. to _____ ft., From _____ ft. to _____ ft.

6 GROUT MATERIAL: 1 Neat cement 2 Cement grout 3 Bentonite 4 Other _____
 Grout Intervals: From 18 ft. to 1 ft., From _____ ft. to _____ ft., From _____ ft. to _____ ft.
 What is the nearest source of possible contamination:
 1 Septic tank 4 Lateral lines 7 Pit privy 10 Livestock pens 14 Abandoned water well
 2 Sewer lines 5 Cess pool 8 Sewage lagoon 11 Fuel storage 15 Oil well/Gas well
 3 Watertight sewer lines 6 Seepage pit 9 Feedyard 12 Fertilizer storage 16 Other (specify below)
pipeline
 Direction from well? East How many feet? ~150

FROM	TO	LITHOLOGIC LOG	FROM	TO	PLUGGING INTERVALS
0	21	Clay, orange brown, firm, dry			
21	24.5	Clay and fractured Limestone			
24.5	26.5	Limestone, shaley			

7 CONTRACTOR'S OR LANDOWNER'S CERTIFICATION: This water well was (1) constructed, (2) reconstructed, or (3) plugged under my jurisdiction and was completed on (mo/day/year) 2/27/05 and this record is true to the best of my knowledge and belief. Kansas Water Well Contractor's License No. 529 This Water Well Record was completed on (mo/day/yr) _____ under the business name of Geotechnology, Inc. by (signature) [Signature]

OFFICE USE ONLY T R E M SEC. 1/4 1/4 1/4