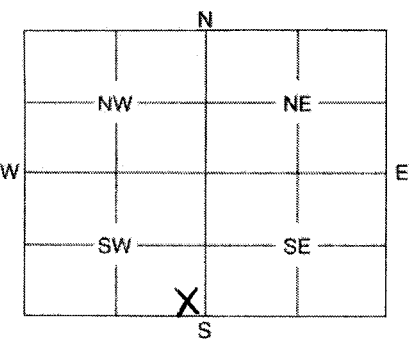


1	LOCATION OF WATER WELL: Johnson	Fraction SW $\frac{1}{4}$ SE $\frac{1}{4}$ SE $\frac{1}{4}$	Section Number 11	Township Number 12S	Range Number 24	EW
---	---	--	-----------------------------	-------------------------------	---------------------------	-----------

Distance and direction from nearest town or city street address of well if located within city?

Zarda Dairy 10606 Shawnee Mission Parkway, Kansas City, Ks

2	WATER WELL OWNER: Mid American Drymen	
	RR #, St. Address, Box #: 3253 E. Chestnut Expressway	Board of Agriculture, Division of Water Resources
	City, State, ZIP Code: Springfield, MO 65802	Application Number:

3	MARK WELL'S LOCATION WITH AN "X" IN SECTION BOX:	4	DEPTH OF WELL 12.96 ft.
			WELL'S STATIC WATER LEVEL 5.11 ft.
			WELL WAS USED AS:
			1 Domestic 5 Public Water Supply 9 Dewatering 2 Irrigation 6 Oil Field Water Supply 10 Monitoring Well 3 Feedlot 7 Domestic (Lawn & Garden) 11 Injection Well 4 Industrial 8 Air Conditioning 12 Other
			Was a chemical / bacteriological sample submitted to Department? Yes No X
			If yes, mo/day/yr sample was submitted
			Water Well Disinfected: Yes No X

5	TYPE OF BLANK CASING USED:	
	1 Steel 3 RMP (SR) 5 Wrought 7 Fiberglass 9 Other (Specify below) ② PVC 4 ABS 6 Asbestos-Cement 8 Concrete Tile	
	Blank casing diameter 2 in.	Was casing pulled? Yes X No If yes, how much 13
	Casing height above or below land surface in.	

6	GROUT PLUG MATERIAL: 1 Neat cement 2 Cement grout ③ Bentonite 4 Other	
	Grout Plug Intervals: From 13 ft. to 0 ft. From ft. to ft. From ft. to ft.	
	What is the nearest source of possible contamination:	
	1 Septic tank 6 Seepage pit 11 Fuel storage 16 Other (specify below) 2 Sewer lines 7 Pit privy 12 Fertilizer storage 3 Watertight sewer lines 8 Sewage lagoon 13 Insecticide storage 4 Lateral lines 9 Feedyard 14 Abandoned water well 5 Cess pool 10 Livestock pens 15 Oil well/Gas well	
	Direction from well? How many feet?	

FROM	TO	PLUGGING MATERIALS
13	0	Bentonite Grout

7	CONTRACTOR'S OF LANDOWNER'S CERTIFICATION: This water well was plugged under my jurisdiction and was completed on (mo/day/year) 09/12/05 and this record is true to the best of my knowledge and belief. Kansas Water Well Contractor's License No. 585 This Water Well Record was completed on (mo/day/year) 10/10/05 under the business name of Associated Environmental, Inc.	
	by (signature) Bradley J. Johnson	

INSTRUCTIONS: Use typewriter or ball point pen. Please press firmly and print clearly. Please fill in blanks, underline or circle the correct answers. Send top three copies to Kansas Department of Health and Environment, Bureau of Water, Geology Section, 1000 SW Jackson St., Ste. 420, Topeka, Kansas 66612-1367. Telephone: 785/296-5522. Send one to Water Well Owner and retain one for your records.