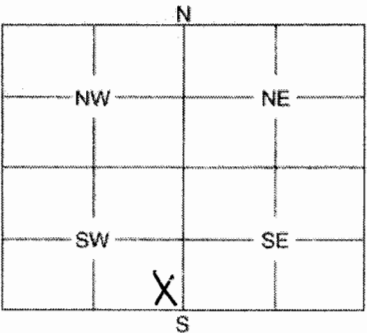


1	LOCATION OF WATER WELL: Johnson County:	Fraction SW $\frac{1}{4}$ SE $\frac{1}{4}$ SE $\frac{1}{4}$	Section Number 11	Township Number 12S	Range Number 24																					
Distance and direction from nearest town or city street address of well if located within city? Zarda Dairy 10606 Shawnee Mission Parkway, Kansas City, Ks																										
2	WATER WELL OWNER: Mid American Drymen RR #, St. Address, Box #: 3253 E. Chestnut Expressway City, State, ZIP Code : Springfield, MO 65802 Board of Agriculture, Division of Water Resources Application Number:																									
3	MARK WELL'S LOCATION WITH AN "X" IN SECTION BOX: <div style="text-align: center;"></div>		4 DEPTH OF WELL 14.06 ft. WELL'S STATIC WATER LEVEL 4.97 ft. WELL WAS USED AS: <table style="width:100%;"><tr><td>1 Domestic</td><td>5 Public Water Supply</td><td>9 Dewatering</td></tr><tr><td>2 Irrigation</td><td>6 Oil Field Water Supply</td><td>(10) Monitoring Well</td></tr><tr><td>3 Feedlot</td><td>7 Domestic (Lawn & Garden)</td><td>11 Injection Well</td></tr><tr><td>4 Industrial</td><td>8 Air Conditioning</td><td>12 Other</td></tr></table> Was a chemical / bacteriological sample submitted to Department? Yes No X If yes, mo/day/yr sample was submitted Water Well Disinfected: Yes No X			1 Domestic	5 Public Water Supply	9 Dewatering	2 Irrigation	6 Oil Field Water Supply	(10) Monitoring Well	3 Feedlot	7 Domestic (Lawn & Garden)	11 Injection Well	4 Industrial	8 Air Conditioning	12 Other									
1 Domestic	5 Public Water Supply	9 Dewatering																								
2 Irrigation	6 Oil Field Water Supply	(10) Monitoring Well																								
3 Feedlot	7 Domestic (Lawn & Garden)	11 Injection Well																								
4 Industrial	8 Air Conditioning	12 Other																								
5	TYPE OF BLANK CASING USED: <table style="width:100%;"><tr><td>1 Steel</td><td>3 RMP (SR)</td><td>5 Wrought</td><td>7 Fiberglass</td><td>9 Other (Specify below)</td></tr><tr><td>(2) PVC</td><td>4 ABS</td><td>6 Asbestos-Cement</td><td>8 Concrete Tile</td><td></td></tr></table> Blank casing diameter 2 in. Was casing pulled? Yes X No If yes, how much 15 Casing height above or below land surface in.					1 Steel	3 RMP (SR)	5 Wrought	7 Fiberglass	9 Other (Specify below)	(2) PVC	4 ABS	6 Asbestos-Cement	8 Concrete Tile												
1 Steel	3 RMP (SR)	5 Wrought	7 Fiberglass	9 Other (Specify below)																						
(2) PVC	4 ABS	6 Asbestos-Cement	8 Concrete Tile																							
6	GROUT PLUG MATERIAL: 1 Neat cement 2 Cement grout (3) Bentonite 4 Other Grout Plug Intervals: From 15 ft. to 0 ft., From ft. to ft., From to ft. What is the nearest source of possible contamination: <table style="width:100%;"><tr><td>1 Septic tank</td><td>6 Seepage pit</td><td>11 Fuel storage</td><td>16 Other (specify below)</td></tr><tr><td>2 Sewer lines</td><td>7 Pit privy</td><td>12 Fertilizer storage</td><td></td></tr><tr><td>3 Watertight sewer lines</td><td>8 Sewage lagoon</td><td>13 Insecticide storage</td><td></td></tr><tr><td>4 Lateral lines</td><td>9 Feedyard</td><td>14 Abandoned water well</td><td></td></tr><tr><td>5 Cess pool</td><td>10 Livestock pens</td><td>15 Oil well/Gas well</td><td></td></tr></table> Direction from well? How many feet?					1 Septic tank	6 Seepage pit	11 Fuel storage	16 Other (specify below)	2 Sewer lines	7 Pit privy	12 Fertilizer storage		3 Watertight sewer lines	8 Sewage lagoon	13 Insecticide storage		4 Lateral lines	9 Feedyard	14 Abandoned water well		5 Cess pool	10 Livestock pens	15 Oil well/Gas well		
1 Septic tank	6 Seepage pit	11 Fuel storage	16 Other (specify below)																							
2 Sewer lines	7 Pit privy	12 Fertilizer storage																								
3 Watertight sewer lines	8 Sewage lagoon	13 Insecticide storage																								
4 Lateral lines	9 Feedyard	14 Abandoned water well																								
5 Cess pool	10 Livestock pens	15 Oil well/Gas well																								
<table border="1" style="width:100%; border-collapse: collapse;"><thead><tr><th style="width:15%;">FROM</th><th style="width:15%;">TO</th><th style="width:70%;">PLUGGING MATERIALS</th></tr></thead><tbody><tr><td style="text-align: center;">15</td><td style="text-align: center;">0</td><td style="text-align: center;">Bentonite Grout</td></tr><tr><td> </td><td> </td><td> </td></tr><tr><td> </td><td> </td><td> </td></tr><tr><td> </td><td> </td><td> </td></tr><tr><td> </td><td> </td><td> </td></tr><tr><td> </td><td> </td><td> </td></tr></tbody></table>						FROM	TO	PLUGGING MATERIALS	15	0	Bentonite Grout															
FROM	TO	PLUGGING MATERIALS																								
15	0	Bentonite Grout																								
7	CONTRACTOR'S OF LANDOWNER'S CERTIFICATION: This water well was plugged under my jurisdiction and was completed on (mo/day/year) 09/13/05 and this record is true to the best of my knowledge and belief. Kansas Water Well Contractor's License No. 585 This Water Well Record was completed on (mo/day/year) 10/10/05 under the business name of Associated Environmental, Inc. by (signature) Bradley J. Johnson																									
INSTRUCTIONS: Use typewriter or ball point pen. Please press firmly and print clearly. Please fill in blanks, underline or circle the correct answers. Send top three copies to Kansas Department of Health and Environment, Bureau of Water, Geology Section, 1000 SW Jackson St., Ste. 420, Topeka, Kansas 66612-1367. Telephone: 785/296-5522. Send one to Water Well Owner and retain one for your records.																										