

CORRECTION(S) TO WATER WELL RECORD (WWC-5)

(to rectify lacking or incorrect information)

Location listed as:

Section-Township-Range: 3-125-24E

Fraction (  $\frac{1}{4}$   $\frac{1}{4}$   $\frac{1}{4}$ ): SE Section 4/SW

County: Johnson

Location changed to:

3-125-24E

NW NW SW SW

Other changes: Initial statements: \_\_\_\_\_

Changed to: \_\_\_\_\_

Comments: \_\_\_\_\_

verification method: Written & legal descriptions, attached map, aerial photos  
on KGS website, and Shawnee 1:24,000 topo. map.

initials: DRL date: 10/26/2005


submitted by: Kansas Geological Survey, Data Resources Library, 1930 Constant Ave., Lawrence, KS 66047-3726  
to: Kansas Dept of Health & Environment, Bureau of Water, 1000 SW Jackson, Suite 420, Topeka, KS 66612-1367.


INSTRUCTIONS: Use typewriter or ball point pen. PLEASE PRESS FIRMLY and PRINT clearly. Please fill in blanks, underline or circle the correct answers. Send top three copies to Kansas Department of Health and Environment, Bureau of Water, Geology Section, 1000 SW Jackson St., Suite 420, Topeka, Kansas 66612-1367. Telephone 785-296-5522. Send one to WATER WELL OWNER and retain one for your records. Fee of \$5.00 for each constructed well.

# FIELD BORING LOG

### AFTER DRILLING

RECEIVED  
JAN 06 2005  
BUREAU OF WATER

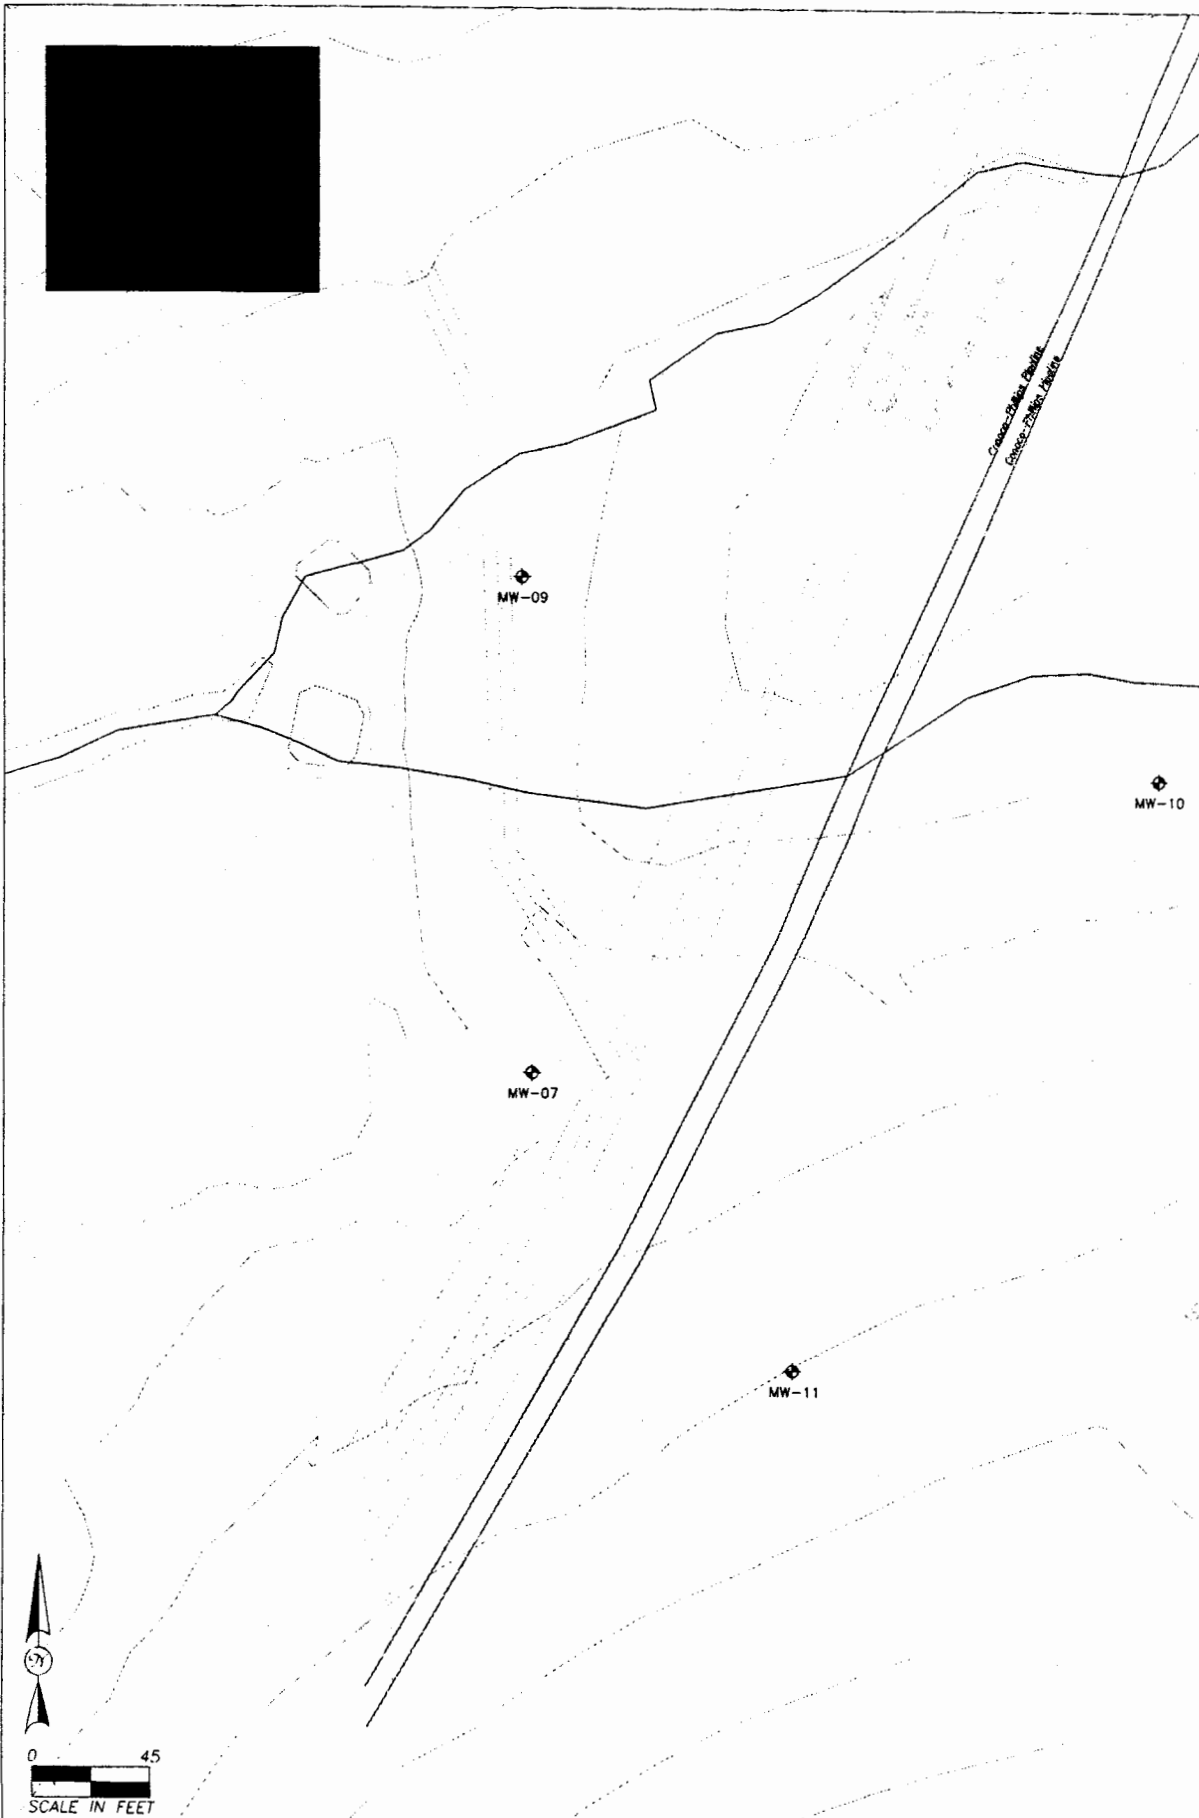

DATE	REVISED	 <p>           Prepared By:  <b>LEGGETTE, BRASHEARS &amp; GRAHAM, INC.</b>            Professional Ground-Water and            Environmental Engineering Services            2103 Burlington Street            North Kansas City, Missouri 64116            (816) 421-7766         </p>	<p> <b>MAGELLAN PIPELINE COMPANY, L.P.</b>            55th &amp; PFLUMM / 53rd &amp; SUMMIT RELEASE SITE            SHAWNEE, KANSAS  <b>WELL LOCATIONS</b> </p>
FILE:	1353VCIR30D.DWG	DATE: DECEMBER 2004	FIGURE: 2