

CORRECTION(S) TO WATER WELL RECORD (WWC-5)

(to rectify lacking or incorrect information)

County: Johnson

Location listed as:

Section-Township-Range: 3-12S-24E

Fraction (¼ ¼ ¼): SE Section 4/SW

Location changed to:

3-12S-24E

W2 W2 W2 SW

Other changes: Initial statements: _____

Changed to: _____

Comments: _____

verification method: written & legal descriptions, attached map, aerial photos
on KGS website, and Shawnee 1:24,000 topo. map.

initials: DRK date: 10/26/2005

submitted by: Kansas Geological Survey, Data Resources Library, 1930 Constant Ave., Lawrence, KS 66047-3726
to: Kansas Dept of Health & Environment, Bureau of Water, 1000 SW Jackson, Suite 420, Topeka, KS 66612-1367.

Boart Longyear

FIELD BORING LOG

SHEET 1 OF 1

DATE: 11/23/2004

JOB # 3417-2029

BORING # MW-10

RIG # 1402

DRILLER: J. Robinson

CLIENT: LB & G

LOCATION: Shawnee, KS

GROUNDWATER

WHILE DRILLING


AFTER DRILLING

VISUAL FIELD CLASSIFICATION & REMARKS	DEPTH	SAMPLE #	MOISTURE	RECOVERY %	SAMPLE SIZE "
Backfill	5'	1		100%	
	10'				
Rock	14'	2		90%	
	20'				
	24'				
	30'				
	35'				
RECEIVED

JAN 06 2005

BUREAU OF WATER

 

DATE	REVISED

Prepared By:
LEGGETTE, BRASHEARS & GRAHAM, INC.
 Professional Ground-Water and
 Environmental Engineering Services
 2103 Burlington Street
 North Kansas City, Missouri 64116
 (816) 421-7766

MAGELLAN PIPELINE COMPANY, L.P.
 55th & PFLUMM / 53rd & SUMMIT RELEASE SITE
 SHAWNEE, KANSAS
 WELL LOCATIONS

FILE: 1353VCIR30D.DWG DATE: DECEMBER 2004 FIGURE: 2