


SE 1/4 of T6 SE 1/4 of Sec. 9, T. 12S & R. 24E

FEET BELOW GRADE

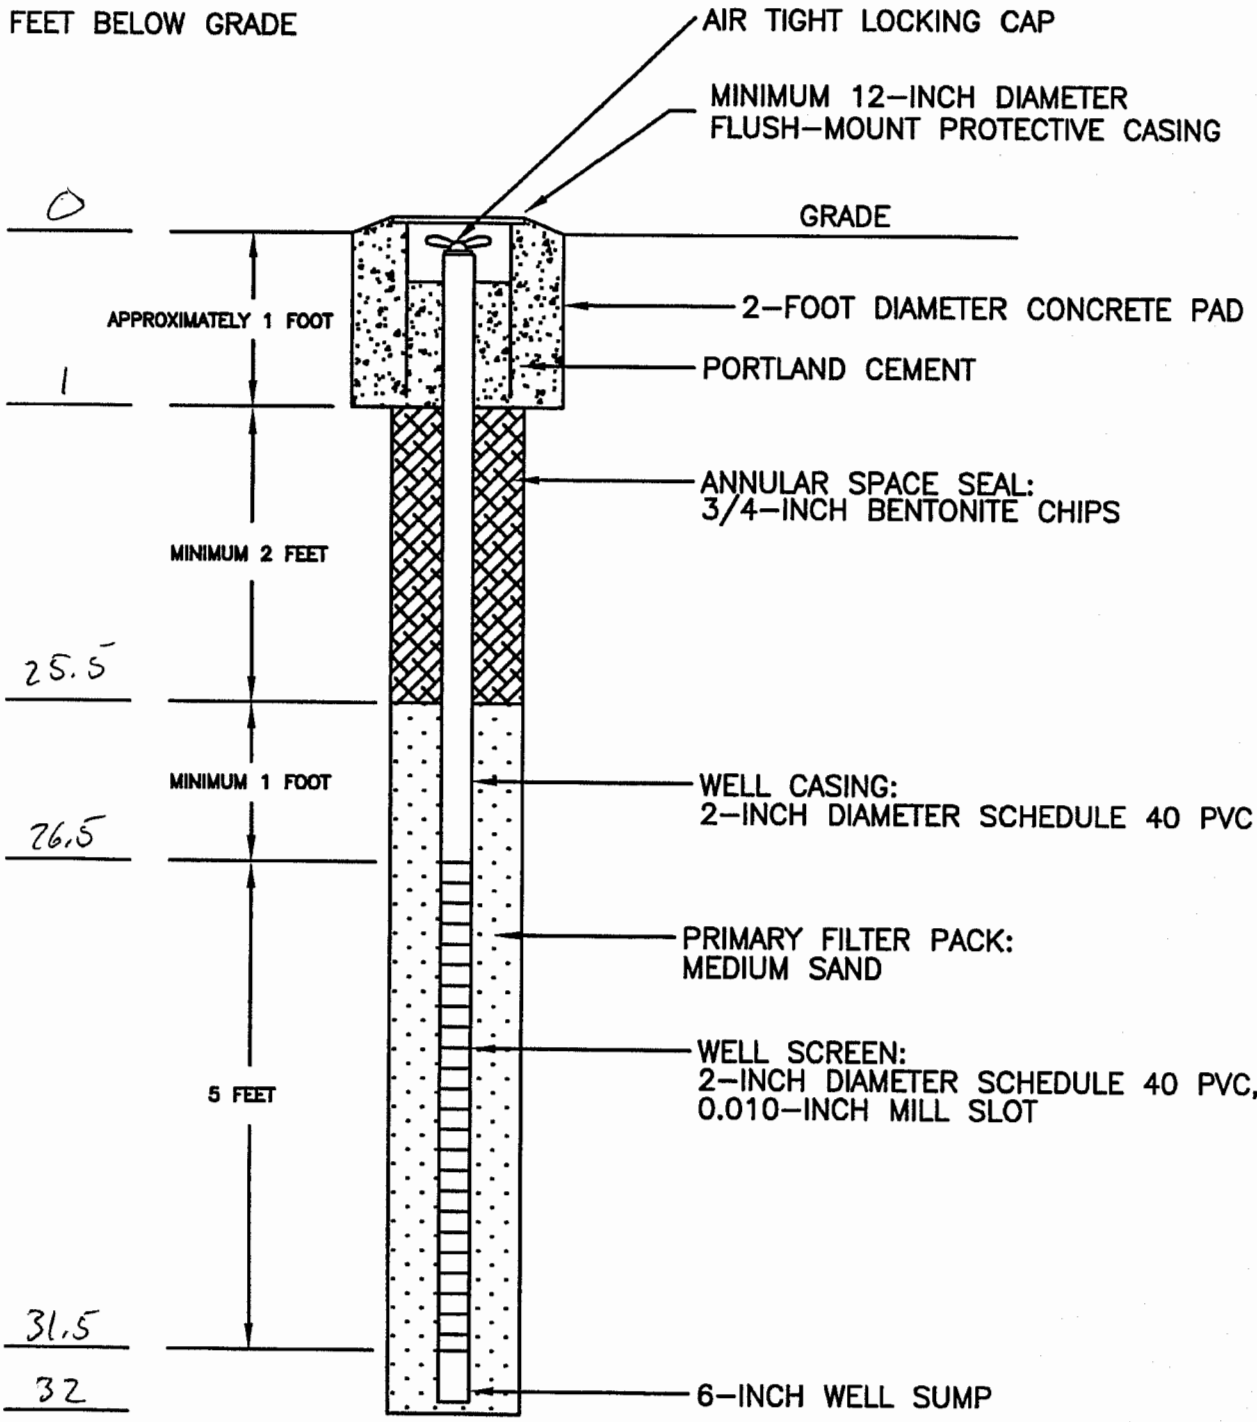

NOT TO SCALE

COMPLETED ON: 3/30/04

DATE	REVISED	Prepared By:	MAGELLAN PIPELINE COMPANY, LLC.
		LEGGETTE, BRASHEARS & GRAHAM, INC.	55th & PFLUMM / 53rd & SUMMIT RELEASE SITE
		Professional Ground-Water and Environmental Engineering Services	SHAWNEE, KANSAS
		2103 Burlington Street	MONITORING WELL 01 CONSTRUCTION DIAGRAM
		North Kansas City, Missouri 64116	FLUSH GRADE COMPLETION
		(816) 481-7786	FILE: MW 01.DWG DATE: MAY 2004 FIGURE: 1

