


FEET BELOW GRADE

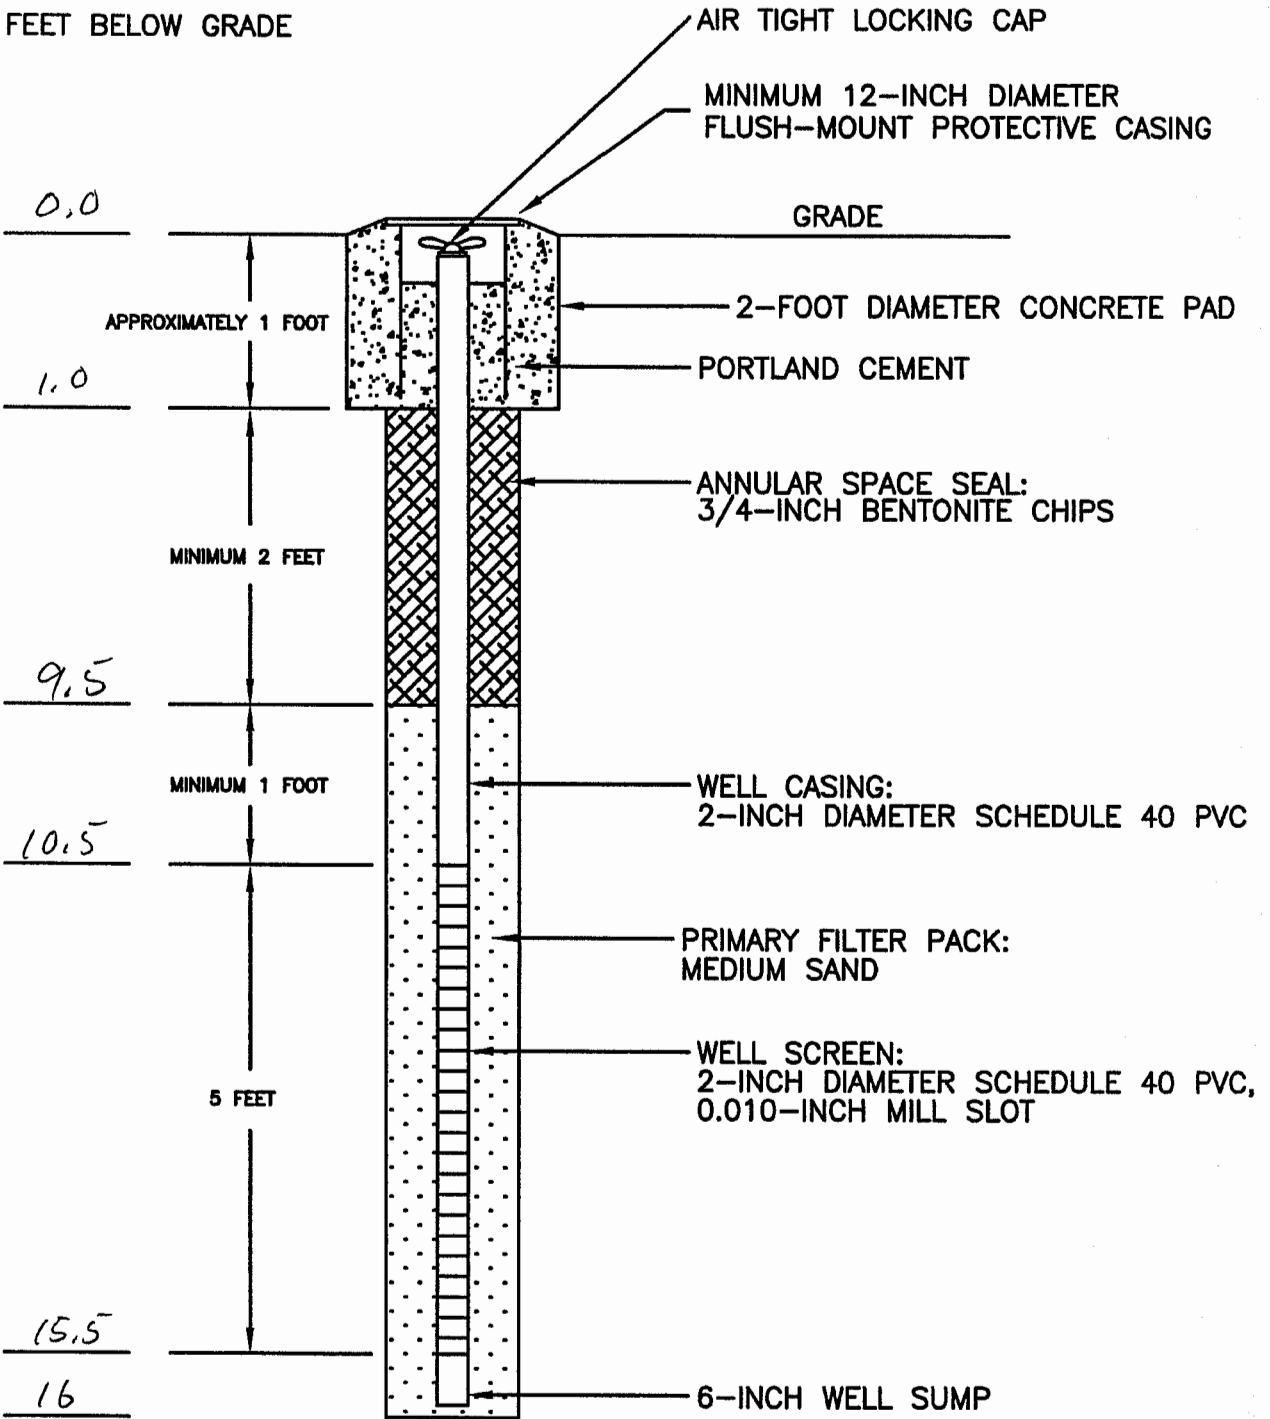

NOT TO SCALE

COMPLETED ON: 4/5/04

DATE	REVISED	Prepared By:	MAGELLAN PIPELINE COMPANY, LLC.
		LEGGETTE, BRASHEARS & GRAHAM, INC.	55th & PFLUMM / 53rd & SUMMIT RELEASE SITE
		Professional Ground-Water and Environmental Engineering Services	SHAWNEE, KANSAS
		2103 Burlington Street	MONITORING WELL 02D CONSTRUCTION DIAGRAM
		North Kansas City, Missouri 64116	FLUSH GRADE COMPLETION
		(816) 421-7708	FILE: MW 02D.DWG DATE: MAY 2004 FIGURE: 1

