

**CORRECTION(S) TO WATER WELL RECORD (WWC-5)**

(to rectify lacking or incorrect information)

County: Johnson

**Location listed as:**

Section-Township-Range: none listed

Fraction (  $\frac{1}{4}$   $\frac{1}{4}$   $\frac{1}{4}$ ): \_\_\_\_\_

**Location changed to:**

4-12-24E

SE SE SE

**Other changes:** Initial statements: \_\_\_\_\_

Changed to: \_\_\_\_\_

Comments: \_\_\_\_\_


verification method: address of well, relation to other wells in series at same address

initials: DA date: 11/28/05

submitted by: Kansas Geological Survey, Data Resources Library, 1930 Constant Ave., Lawrence, KS 66047-3726  
to: Kansas Dept of Health & Environment, Bureau of Water, 1000 SW Jackson, Suite 420, Topeka, KS 66612-1367.



FEET BELOW GRADE

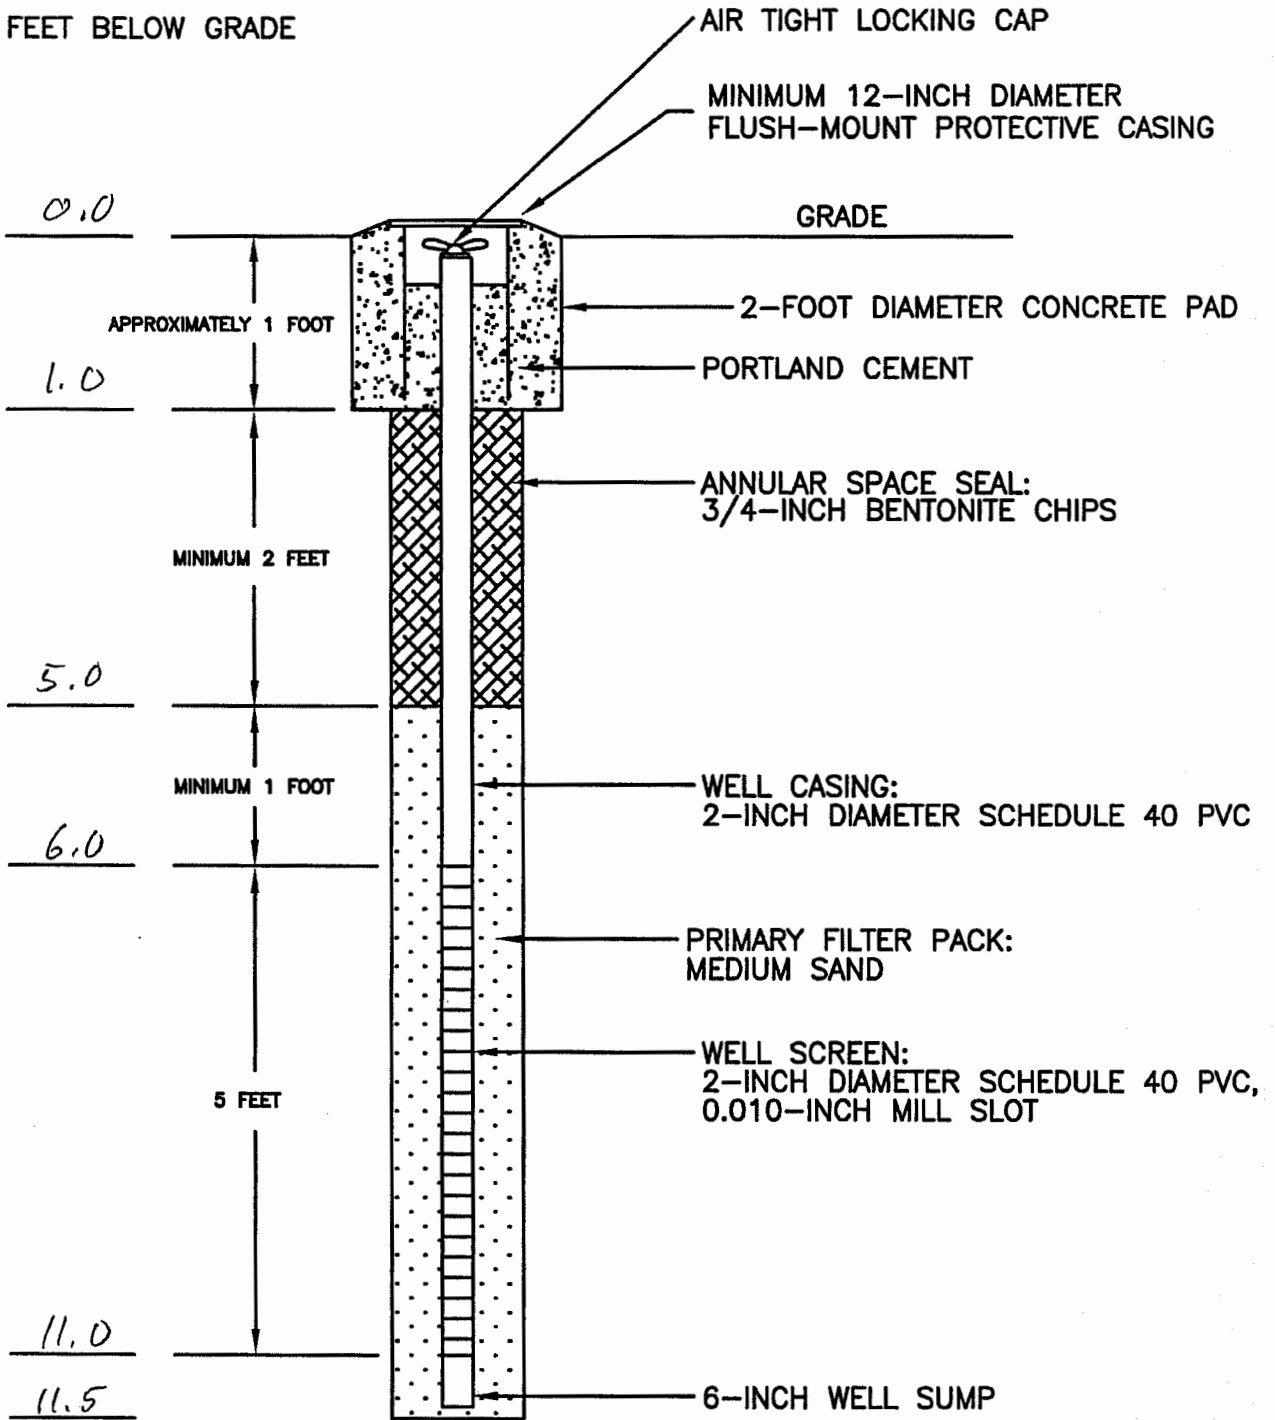

NOT TO SCALE

COMPLETED ON: 4/6/04

DATE	REVISED	Prepared By:	MAGELLAN PIPELINE COMPANY, LLC.
		LEGGETTE, BRASHEARS & GRAHAM, INC.	55th & PFLUMM / 53rd & SUMMIT RELEASE SITE
		Professional Ground-Water and Environmental Engineering Services	SHAWNEE, KANSAS
		2103 Burlington Street	MONITORING WELL 03 CONSTRUCTION DIAGRAM
		North Kansas City, Missouri 64116	FLUSH GRADE COMPLETION
		(816) 481-7768	FILE: MW 03.DWG   DATE: MAY 2004   FIGURE: 1

