


1 LOCATION OF WATER WELL: County: Johnson Fraction: SE 1/4 SE 1/4 SE 1/4 Section Number: 4 Township Number: T 125 S Range Number: R 24 EW

Distance and direction from nearest town or city street address of well if located within city? 55th and Pflumm, Shawnee, KS

2 WATER WELL OWNER: Magellan Pipeline Company LLC RR#, St. Address, Box #: 53rd & Summit City, State, ZIP Code: Shawnee, KS Board of Agriculture, Division of Water Resources Application Number:

3 LOCATE WELL'S LOCATION WITH AN "X" IN SECTION BOX: 4 DEPTH OF COMPLETED WELL: 9.5 ft. ELEVATION: 914.51

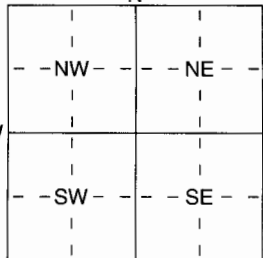

Depth(s) Groundwater Encountered 1 ft. 2 ft. 3 ft. WELL'S STATIC WATER LEVEL: ft. below land surface measured on mo/day/yr Pump test data: Well water was ft. after hours pumping gpm Est. Yield gpm: Well water was ft. after hours pumping gpm WELL WATER TO BE USED AS: 5 Public water supply 8 Air conditioning 11 Injection well 1 Domestic 3 Feedlot 6 Oil field water supply 9 Dewatering 12 Other (Specify below) 2 Irrigation 4 Industrial 7 Domestic (lawn & garden) 10 Monitoring well Was a chemical/bacteriological sample submitted to Department? Yes No; If yes, mo/day/yr sample was submitted Water Well Disinfected? Yes No

5 TYPE OF BLANK CASING USED: 1 Steel 3 RMP (SR) 5 Wrought iron 8 Concrete tile CASING JOINTS: Glued Clamped 2 PVC 4 ABS 6 Asbestos-Cement 9 Other (specify below) Welded 7 Fiberglass Threaded

Blank casing diameter: 2 in. to 4.0 ft. Dia. Casing height above land surface: in., weight lbs./ft. Wall thickness or gauge No. Sch. 40

TYPE OF SCREEN OR PERFORATION MATERIAL: 1 Steel 3 Stainless Steel 5 Fiberglass 7 PVC 8 RMP (SR) 10 Asbestos-Cement 2 Brass 4 Galvanized Steel 6 Concrete tile 9 ABS 11 Other (Specify) 12 None used (open hole)

SCREEN OR PERFORATION OPENINGS ARE: 1 Continuous slot 3 Mill slot 5 Gauzed wrapped 8 Saw cut 11 None (open hole) 2 Louvered shutter 4 Key punched 6 Wire wrapped 9 Drilled holes 10 Other (specify) ft. 7 Torch cut

SCREEN-PERFORATED INTERVALS: From 4.0 ft. to 9.0 ft. GRAVEL PACK INTERVALS: From 3.0 ft. to 9.5 ft.


6 GROUT MATERIAL: 1 Neat cement 2 Cement grout 3 Bentonite 4 Other Grout Intervals: From 1.0 ft. to 3.0 ft.

What is the nearest source of possible contamination: 1 Septic tank 4 Lateral lines 7 Pit privy 10 Livestock pens 14 Abandoned water well 2 Sewer lines 5 Cess pool 8 Sewage lagoon 11 Fuel storage 15 Oil well/Gas well 3 Watertight sewer lines 6 Seepage pit 9 Feedyard 12 Fertilizer storage 16 Other (specify below) 13 Insecticide storage Direction from well? How many feet?

Table with columns: FROM, TO, LITHOLOGIC LOG, FROM, TO, PLUGGING INTERVALS. LITHOLOGIC LOG contains handwritten text: 'See attached Geologic Log'.

7 CONTRACTOR'S OR LANDOWNER'S CERTIFICATION: This water well was (1) constructed, (2) reconstructed, or (3) plugged under my jurisdiction and was completed on (mo/day/year) 6/16/04 and this record is true to the best of my knowledge and belief. Kansas Water Well Contractor's Licence No. 658 This Water Well Record was completed on (mo/day/yr) 7/29/04 under the business name of Board Longyear Env. Drilling Division by (signature)

FEET BELOW GRADE

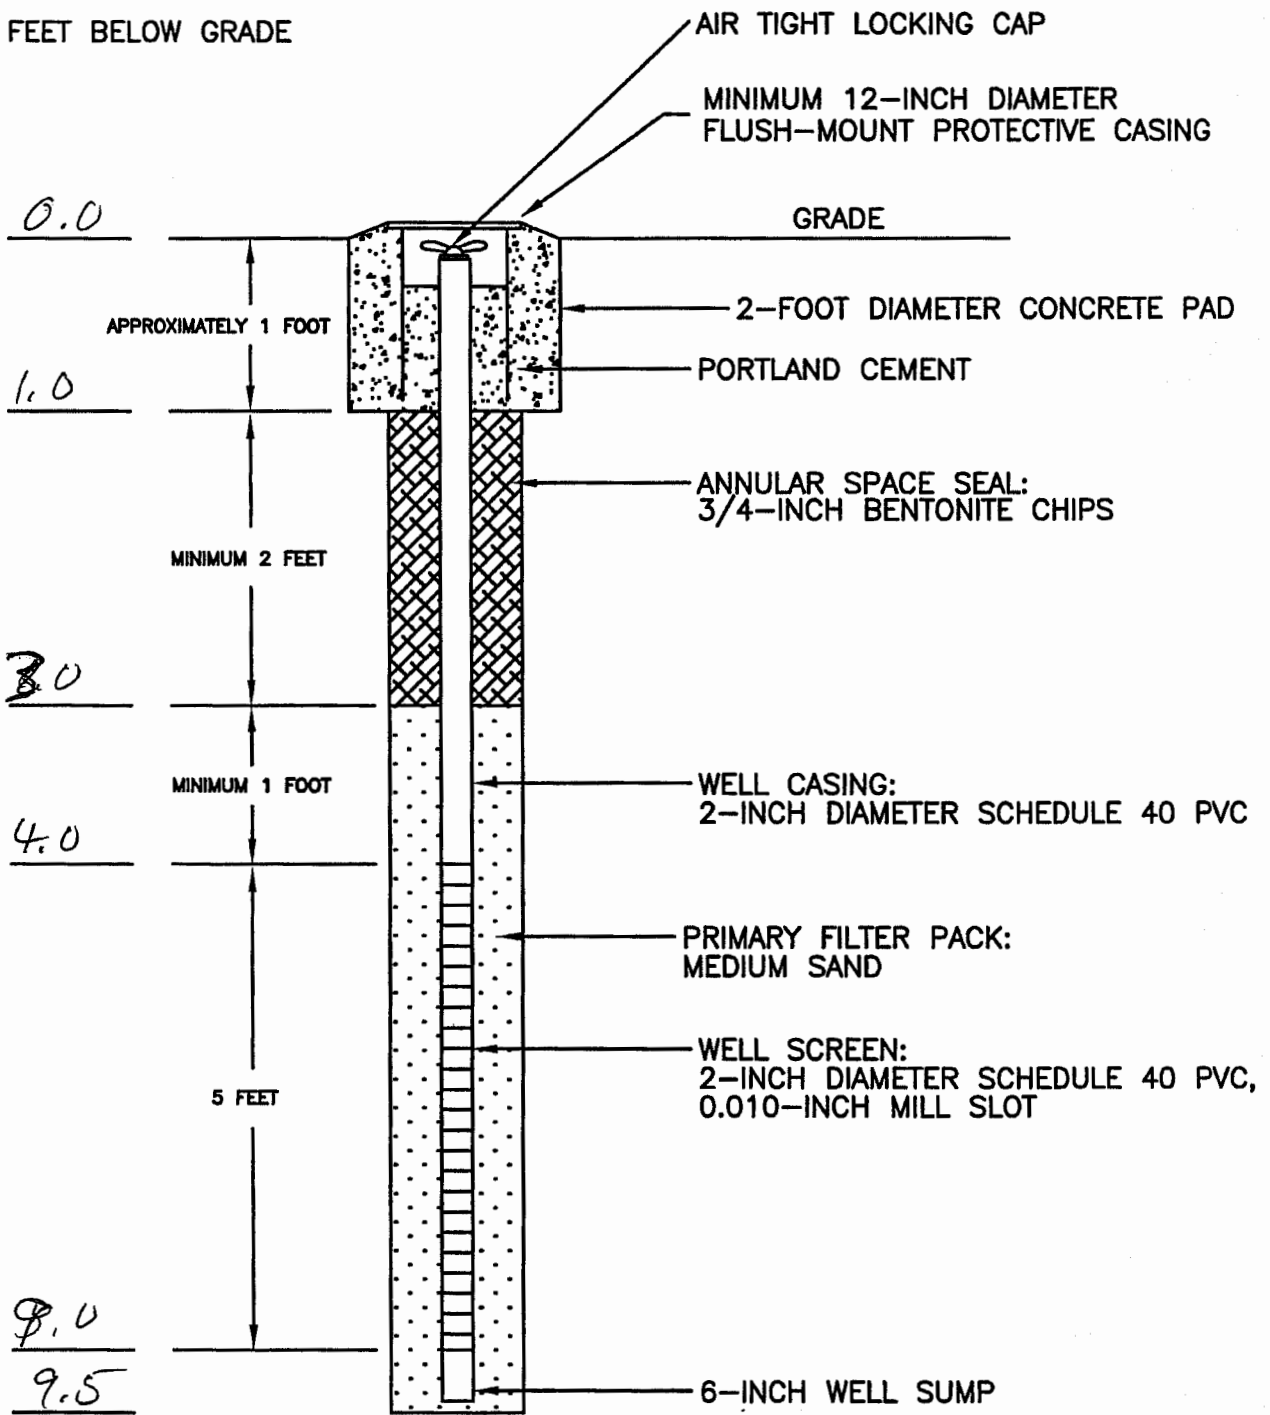

NOT TO SCALE

COMPLETED ON: 6/16/04

DATE	REVISED	Prepared By:	MAGELLAN PIPELINE COMPANY, LLC.
		LEGGETTE, BRASHEARS & GRAHAM, INC.	55th & PFLUMM / 53rd & SUMMIT RELEASE SITE
		Professional Ground-Water and Environmental Engineering Services	SHAWNEE, KANSAS
		2103 Burlington Street	MONITORING WELL 08 CONSTRUCTION DIAGRAM
		North Kansas City, Missouri 64116	FLUSH GRADE COMPLETION
		(816) 481-7788	FILE: MW 08.DWG DATE: MAY 2004 FIGURE: 1

GEOLOGIC LOG

LEGGETTE, BRASHEARS & GRAHAM, INC.
North Kansas City, Missouri

OWNER: Magellan Pipeline Company, LLC

TEST HOLE: MW-08

PAGE 1 OF 1 PAGE(S)

SITE LOCATION: 53rd and Summit	SCREEN SIZE & TYPE:
	SLOT NO.: SETTING:
DATE COMPLETED: 06/16/04	SAND PACK SIZE & TYPE:
DRILLING COMPANY: Boart Longyear	
DRILLING METHOD: Minisonic	
SAMPLING METHOD: core samples	SETTING:
OBSERVER: Brandon M. Gomer	CASING SIZE & TYPE:
REFERENCE POINT (RP) OSTP-B Top of casing	SETTING:
ELEVATION OF RP: 914.51	SEAL TYPE:
STICK-UP:	SETTING:
SURFACE COMPLETION: X	BACKFILL TYPE
REMARKS:	
ABBREVIATIONS: MC=MACRO CORE W=WASH C=CUTTINGS G=GRAB ST=SHELBY TUBE REC=RECOVERY PPM=PARTS PER MILLION FBG=FEET BELOW GRADE	

DEPTH (Feet)		SAMPLE TYPE	RECOVERED (Feet)	PID READING (ppm)	DESCRIPTION
FROM	TO				
0	1		3.5	0.0	CLAY; little silt; medium to dark yellow brown; organic matter, soft. No odor.
1	2			0.0	firmer and friable with fewer organics
2	3			0.0	
3	4			0.0	
4	5			0.0	trace of fine sand
5	6	G	3.0	0.2	CLAY, med yellow brown, soft; little silt; gravel to pebble size clasts, some limestone, rounded and subrounded.
6	7			1.3	increased beige and darkening
7	7.5	G		25.6	LIMESTONE and CLAY, pulverized crystalline L.S., medium yellow orange clay, odor.
7.5	8.5		1.0	3.3	LIMESTONE, shaley, light gray, crystalline
8.5	9		1.5	4.3	minor shale layers
9	10	G		4.3	
terminated					

DRAFT