


FEET BELOW GRADE

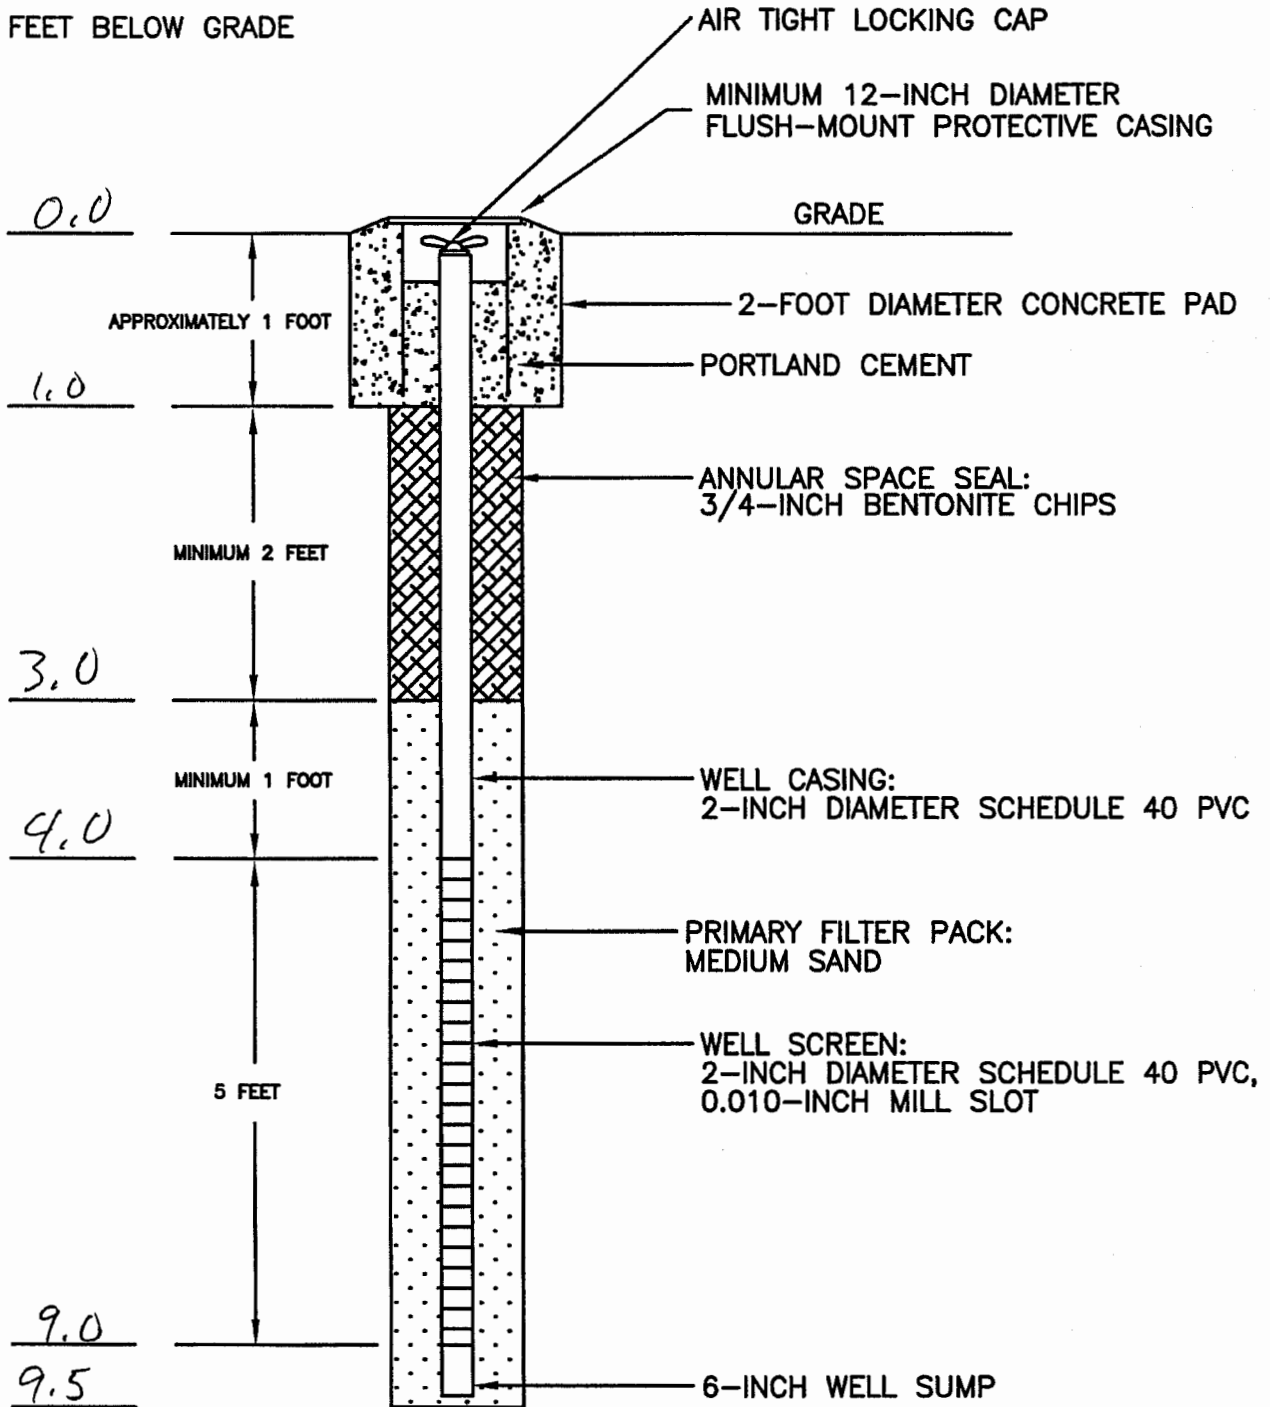

AIR TIGHT LOCKING CAP

MINIMUM 12-INCH DIAMETER FLUSH-MOUNT PROTECTIVE CASING

GRADE

0.0

APPROXIMATELY 1 FOOT

2-FOOT DIAMETER CONCRETE PAD

1.0

PORTLAND CEMENT

MINIMUM 2 FEET

ANNULAR SPACE SEAL:
3/4-INCH BENTONITE CHIPS

3.0

MINIMUM 1 FOOT

WELL CASING:
2-INCH DIAMETER SCHEDULE 40 PVC

4.0

PRIMARY FILTER PACK:
MEDIUM SAND

5 FEET

WELL SCREEN:
2-INCH DIAMETER SCHEDULE 40 PVC,
0.010-INCH MILL SLOT

9.0

9.5

6-INCH WELL SUMP

NOT TO SCALE

COMPLETED ON: 6/16/04

DATE	REVISED

Prepared By:
LEGGETTE, BRASHEARS & GRAHAM, INC.
 Professional Ground-Water and
 Environmental Engineering Services
 2103 Burlington Street
 North Kansas City, Missouri 64116
 (816) 421-7766

MAGELLAN PIPELINE COMPANY, LLC.
 55th & PFLUMM / 53rd & SUMMIT RELEASE SITE
 SHAWNEE, KANSAS

MONITORING WELL 12 CONSTRUCTION DIAGRAM
 FLUSH GRADE COMPLETION

FILE: MW 12.DWG | DATE: MAY 2004 | FIGURE: 1

