

1 LOCATION OF WATER WELL:	Fraction	Section Number	Township Number	Range Number
County: Johnson	SW ¼ SW ¼ SE ¼	34	12 S	24 E

Distance and direction from nearest town or city street address of well if located within city?
Phillips 66 Station, 12420 W 95th St, Lenexa; 60 ft. north and 30 ft. west of the NE corner of the on-site station bldg.

2 WATER WELL OWNER: Phillips 66 Company	Board of Agriculture, Division of Water Resources Application Number:
RR#, St. Address, Box # 1234 Phillips 66 Bldg	
City, State, ZIP Code : Bartlesville, OK 74004	

3 MARK WELL'S LOCATION WITH AN "X" IN SECTION BOX:

N

NW	NE
SW	SE

S

W E

4 DEPTH OF WELL **13** ft.

WELL'S STATIC WATER LEVEL **Unknown** ft.

WELL WAS USED AS:

1 Domestic	5 Public Water Supply	9 Dewatering
2 Irrigation	6 Oil Field Water Supply	10 <u>Monitoring Well</u>
3 Feedlot	7 Lawn and Garden (domestic)	11 Injection Well
4 Industrial	8 Air Conditioning	12 Other

Was a chemical/bacteriological sample submitted to Department? Yes ___ No **X**

If yes, mo/day/yr sample was submitted _____

Water Well Disinfected: Yes ___ No **X**

5 TYPE OF BLANK CASING USED:

1 Steel	3 RMP (SR)	5 Wrought	7 Fiberglass	9 Other (specify below)
2 <u>PVC</u>	4 ABC	6 Asbestos-Cement	8 Concrete Tile	

Blank casing diameter **2** in. Was casing pulled? Yes **X** No ___ If yes, how much **overdrilled 13 ft.**

Casing height above or below land surface **≈6** in.

6 GROUT PLUG MATERIAL: 1 Neat cement 2 Cement grout 3 Bentonite 4 Other

Grout Plug Intervals From **0** ft. to **13** ft. From ___ ft. to ___ ft. From ___ ft. to ___ ft.

What is the nearest source of possible contamination:

1 Septic tank	6 Seepage pit	11 <u>Fuel storage</u>	16 Other (specify below)
2 Sewer lines	7 Pit privy	12 Fertilizer storage	
3 Watertight sewer lines	8 Sewage lagoon	13 Insecticide storage	
4 Lateral lines	9 Feedyard	14 Abandoned water well	
5 Cess Pool	10 Livestock pens	15 Oil well/ Gas well	

Direction from well? **SW** How many feet? **approximately 120**

FROM	TO	CODE	PLUGGING MATERIALS
0	13	--	Bentonite chips

7 CONTRACTOR'S OR LANDOWNER'S CERTIFICATION: This water well was plugged under my jurisdiction and was completed on (mo/day/yr) **7/24/06** and this record is true to the best of my knowledge and belief. Kansas Water Well Contractor's License No. **616** This Water Well Record was completed on (mo/day/yr) **7/27/06** under the business name of **Thiele Geotech, Inc.**

by (signature) *D. J. A. L.*

INSTRUCTIONS: Please fill in blanks and circle the correct answers. Send three copies to Kansas Department of Health and Environment, Bureau of Water, 1000 S W Jackson St., Ste. 420, Topeka, Kansas 66620-0001. Telephone: 785-296-3565. Send one to Water Well Owner and retain one for your records.

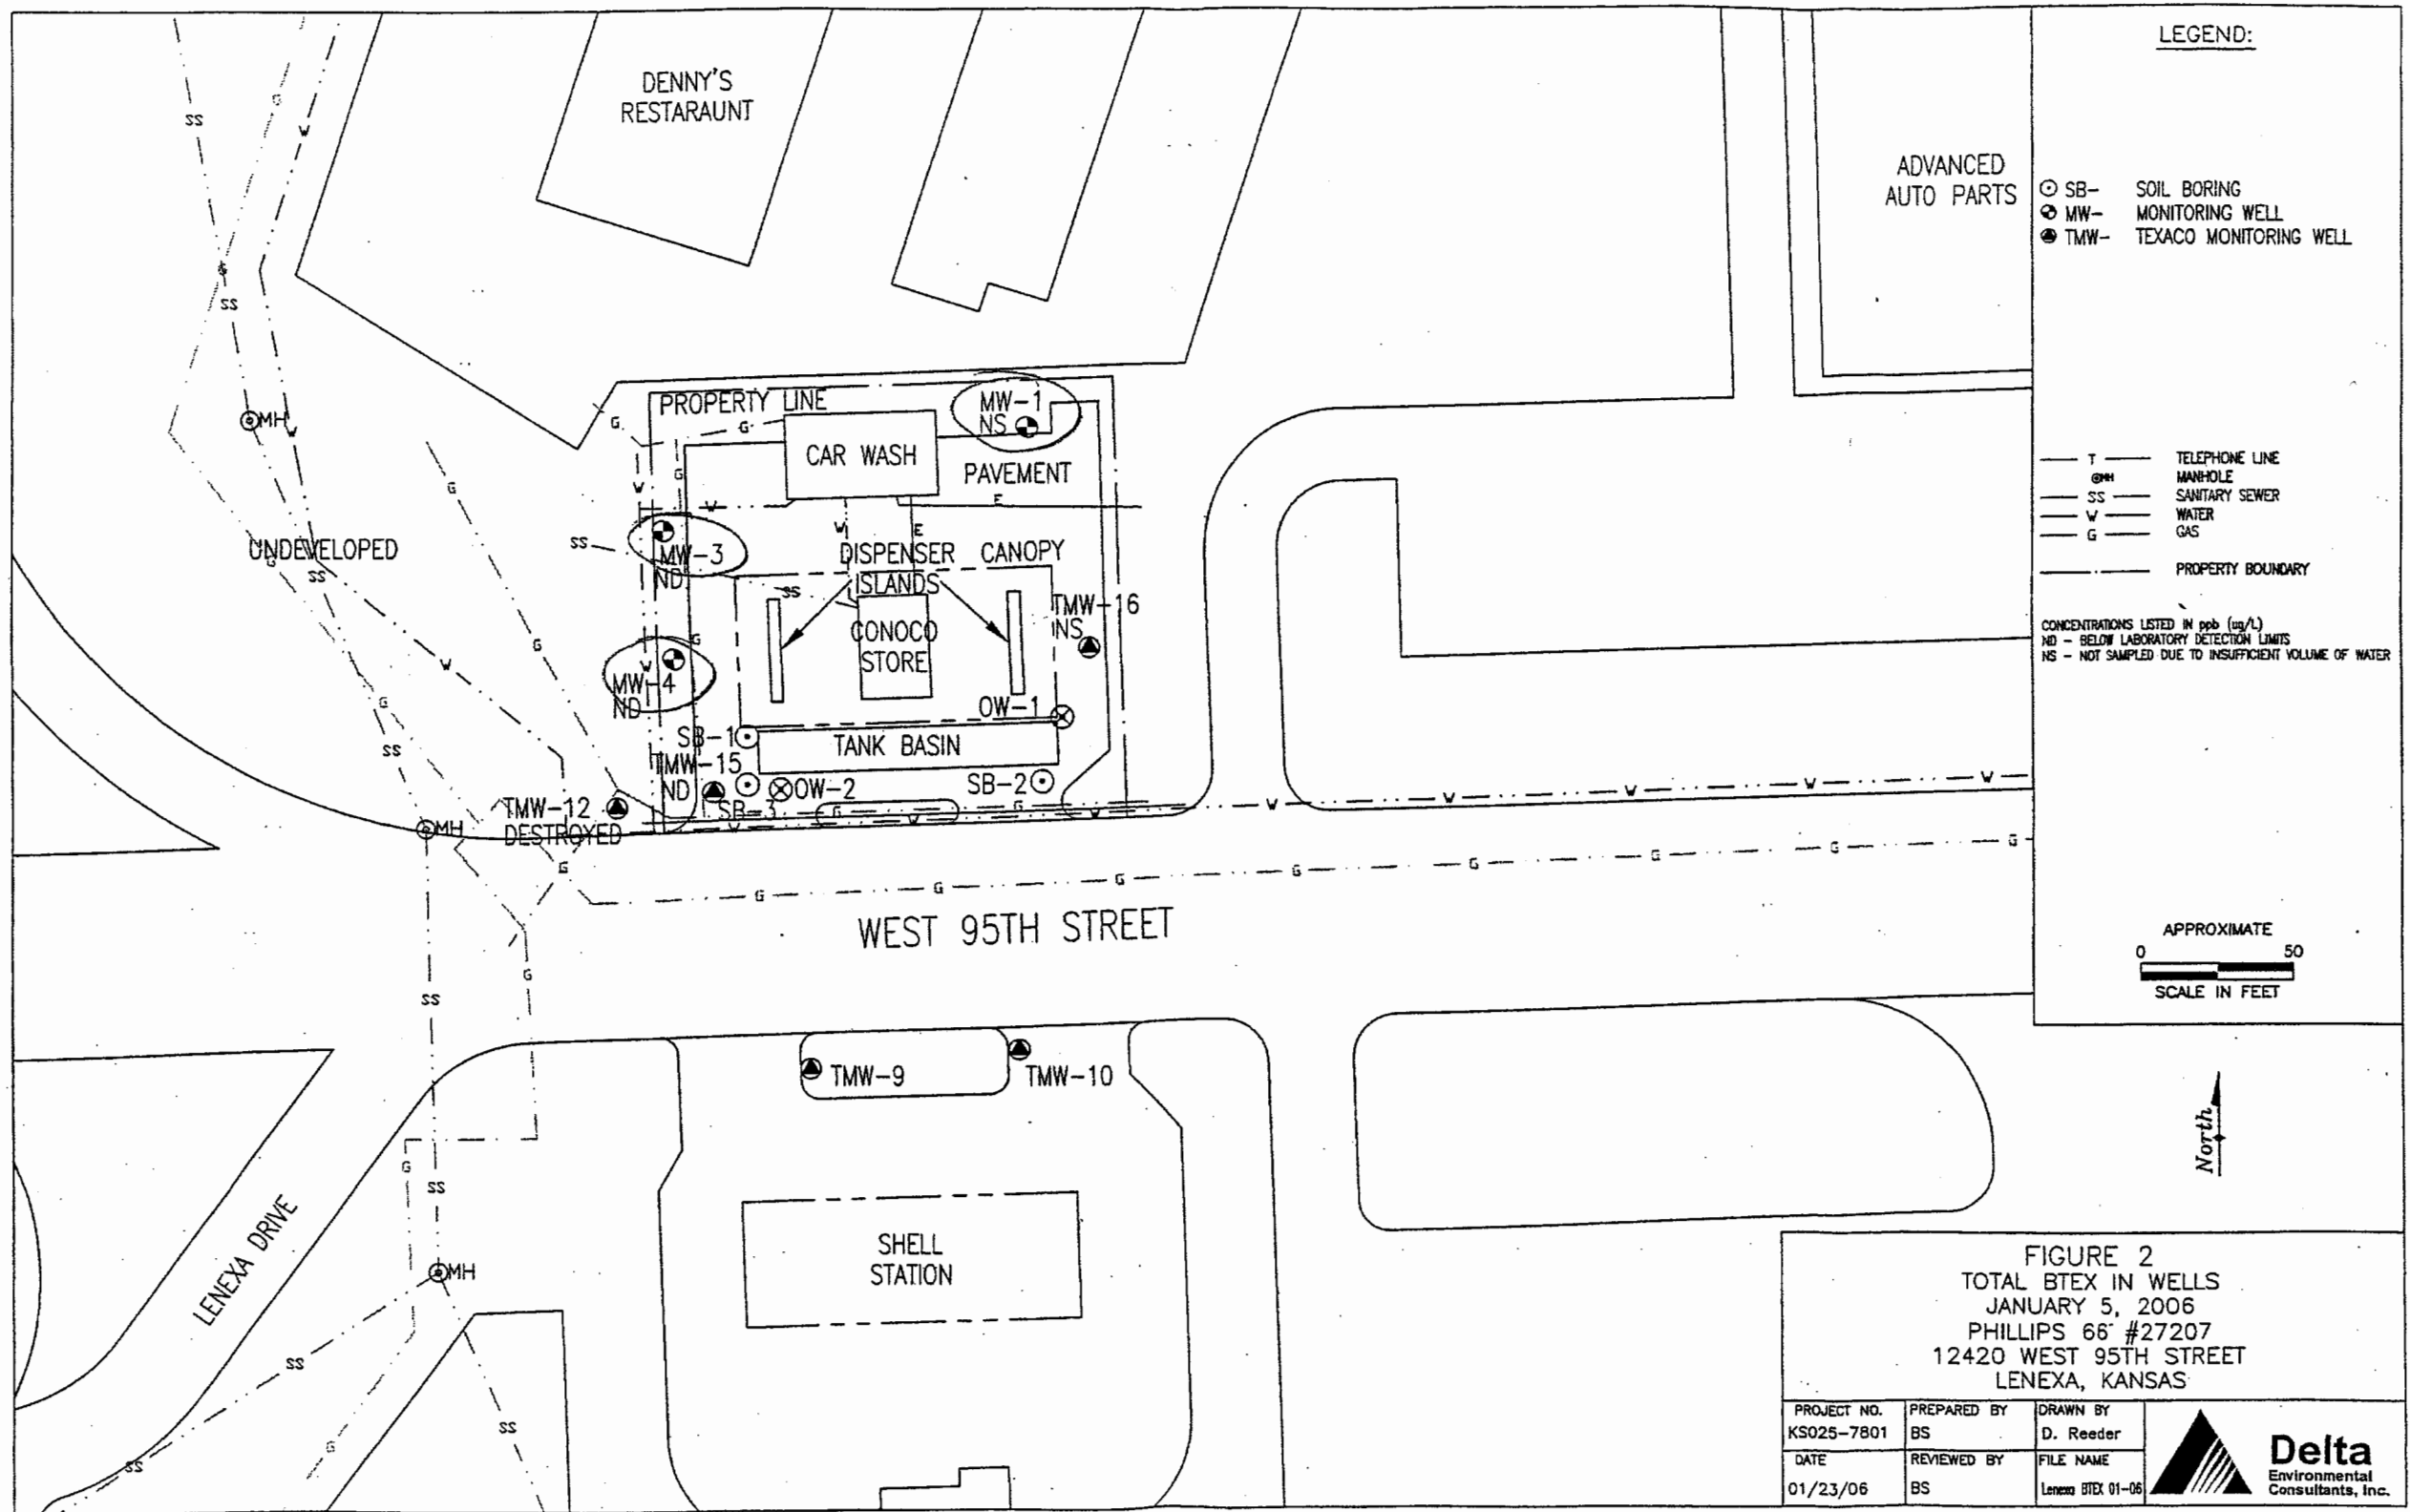


FIGURE 2
 TOTAL BTEX IN WELLS
 JANUARY 5, 2006
 PHILLIPS 66 #27207
 12420 WEST 95TH STREET
 LENEXA, KANSAS

PROJECT NO. KS025-7801	PREPARED BY BS	DRAWN BY D. Reeder
DATE 01/23/06	REVIEWED BY BS	FILE NAME Lenexa BTEX 01-06

