

[illegible]

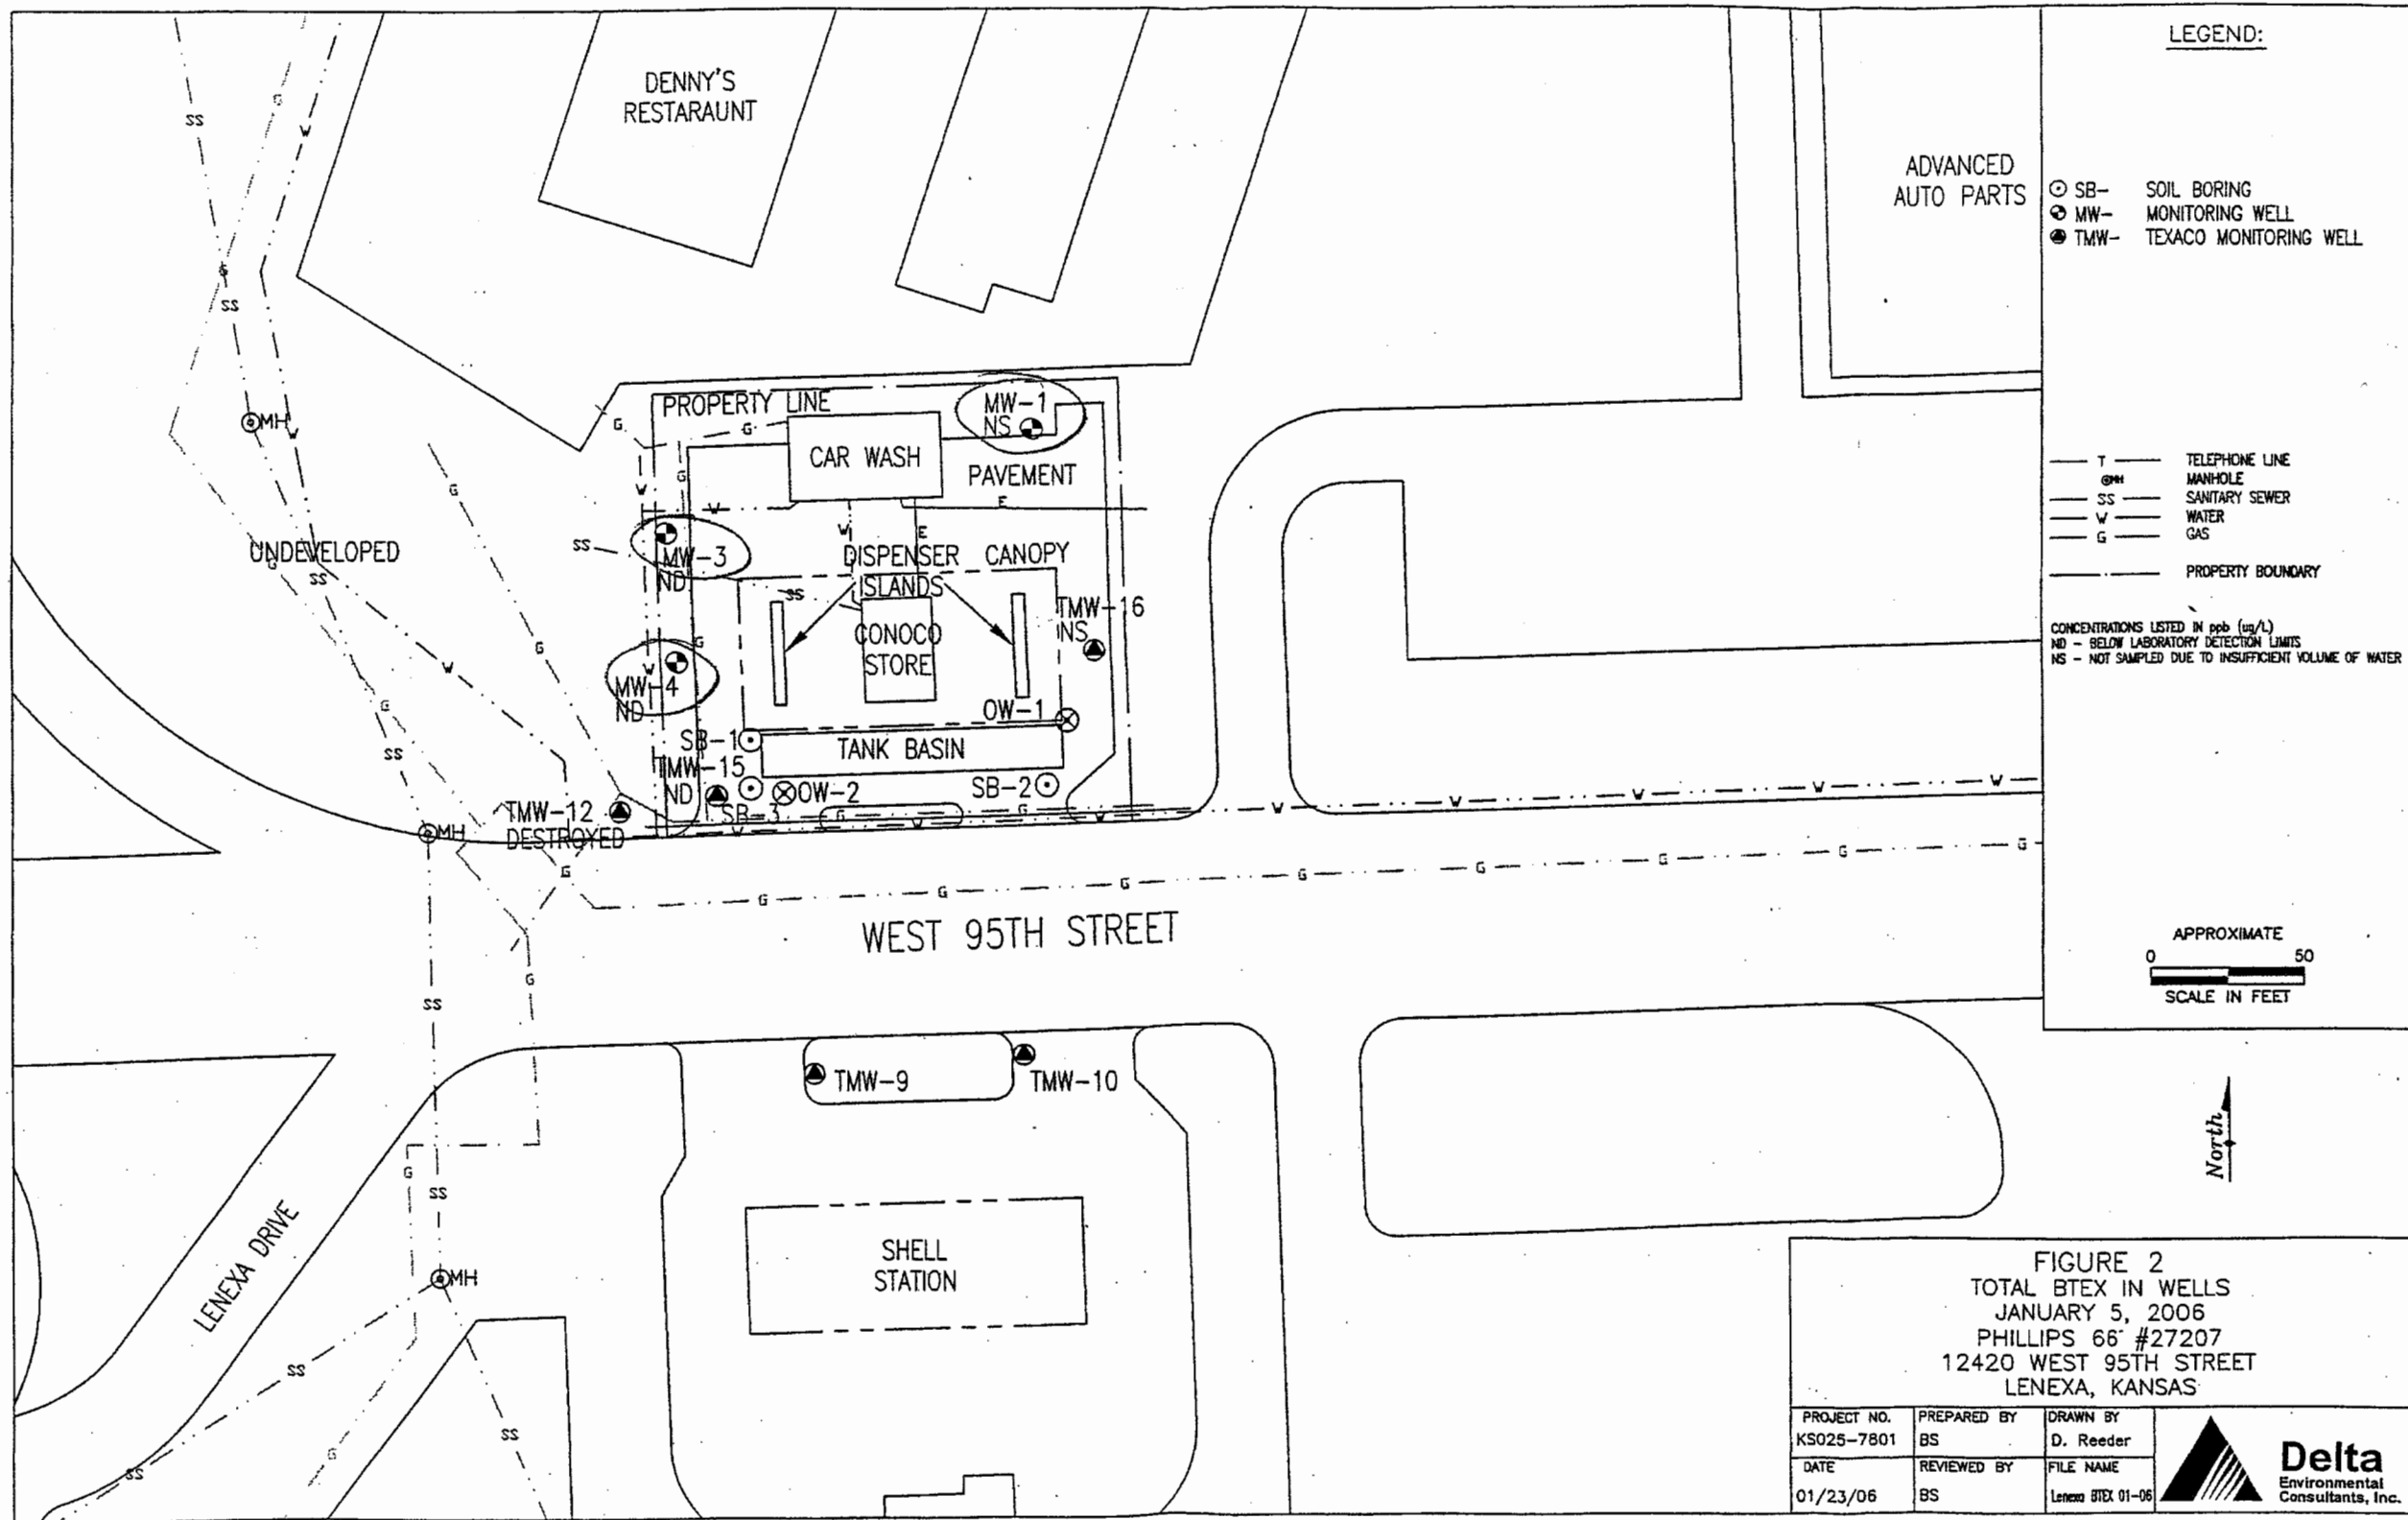


FIGURE 2
 TOTAL BTEX IN WELLS
 JANUARY 5, 2006
 PHILLIPS 66 #27207
 12420 WEST 95TH STREET
 LENEXA, KANSAS

PROJECT NO. KS025-7801	PREPARED BY BS	DRAWN BY D. Reeder	
DATE 01/23/06	REVIEWED BY BS	FILE NAME Lenexa BTEX 01-06	