MW-18 WATER WELL RECORD Form WWC-5 KSA 82a-1212 ID No. _____

1 LOCATION OF WATER WELL:	Fraction	Section Number	Township Number	Range Number
County: Johnson	SW ¼ SW ¼ SW ¼	26	T 12 S	R 24 E/W

Distance and direction from nearest town or city street address of well if located within city?
COP #21260, 8633 Quivira Rd, Lenexa; N 38° 58' 19.67787" W 94° 43' 22.98330"

2 WATER WELL OWNER: Phillips 66 Company
RR#, St. Address, Box # : 1234 Phillips 66 Bldg.
City, State, ZIP Code : Bartlesville, OK 74004

Board of Agriculture, Division of Water Resources
Application Number:

3 LOCATE WELL'S LOCATON WITH AN "X" IN SECTION BOX:

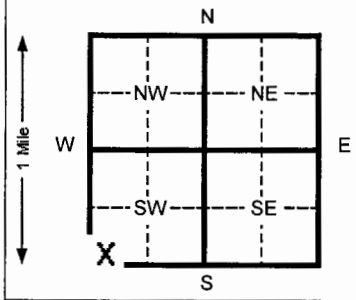

4 DEPTH OF COMPLETED WELL 13.5 ft. ELEVATION: 1056.20 (TOC)
Depth(s) Groundwater Encountered 1 N/A ft. 2 _____ ft. 3 _____ ft.
WELL'S STATIC WATER LEVEL 12.42 ft. below land surface measured on mo/day/yr 5/8/07
Pump test data: Well water was _____ ft. after _____ hours pumping _____ gpm
Est. Yield unk gpm: Well water was _____ ft. after _____ hours pumping _____ gpm
Bore Hole Diameter 8 in. to 13.5 ft. and _____ in. to _____ ft.
WELL WATER TO BE USED AS: 5 Public water supply 8 Air conditioning 11 Injection well
1 Domestic 3 Feed lot 6 Oil field water supply 9 Dewatering 12 Other (Specify below)
2 Irrigation 4 Industrial 7 Lawn and garden (domestic) (10) Monitoring well
Was a chemical/bacteriological sample submitted to Department? Yes _____ No X If yes, mo/day/yr sample was submitted
Water Well Disinfected? Yes _____ No X

5 TYPE OF BLANK CASING USED: 5 Wrought Iron 8 Concrete tile CASING JOINTS: Glued _____ Clamped _____
1 Steel 3 RMP (SR) 6 Asbestos-Cement 9 Other (specify below) Welded _____
(2) PVC 4 ABS 7 Fiberglass Threaded X
Blank casing diameter 2 in. to 3 ft., Dia _____ in. to _____ ft., Dia _____ in. to _____ ft.
Casing height above land surface x in., weight 0.682 lbs./ft. Wall thickness or gauge No. 0.1875 in.
TYPE OF SCREEN OR PERFORATION MATERIAL: (7) PVC 10 Asbestos-cement
1 Steel 3 Stainless steel 5 Fiberglass 8 RMP (SR) 11 Other (specify) _____
2 Brass 4 Galvanized steel 6 Concrete tile 9 ABS 12 None used (open hole)
SCREEN OR PERFORATION OPENINGS ARE: 5 Gauzed wrapped 8 Saw cut 11 None (open hole)
1 Continuous slot (3) Mill slot 6 Wire wrapped 9 Drilled holes
2 Louvered shutter 4 Key punched 7 Torch cut 10 Other (specify) _____
SCREEN-PERFORATED INTERVALS: From 3 ft. to 13.5 ft. From _____ ft. to _____ ft.
From _____ ft. to _____ ft. From _____ ft. to _____ ft.
GRAVEL PACK INTERVALS: From 2.5 ft. to 13.5 ft. From _____ ft. to _____ ft.
From _____ ft. to _____ ft. From _____ ft. to _____ ft.

6 GROUT MATERIAL: 1 Neat cement 2 Cement grout (3) Bentonite 4 Other _____
Grout Intervals From 1 ft. to 2.5 ft. From _____ ft. to _____ ft. From _____ ft. to _____ ft.
What is the nearest source of possible contamination: 10 Livestock pens 14 Abandoned water well
1 Septic tank 4 Lateral lines 7 Pit privy (11) Fuel storage 15 Oil well/ Gas well
2 Sewer lines 5 Cess pool 8 Sewage lagoon 12 Fertilizer storage 16 Other (specify below)
3 Watertight sewer lines 6 Seepage pit 9 Feedyard 13 Insecticide storage
Direction from well? south How many feet? approximately 175 ft.

FROM	TO	CODE	LITHOLOGIC LOG	FROM	TO	PLUGGING INTERVALS
0	0.7 ft	--	asphalt			
0.7	1	11	gravel base			
1	13.5	03	brown, silty clay			
13.5	13.5	28	bedrock			

7 CONTRACTOR'S OR LANDOWNER'S CERTIFICATION: This water well was (1) constructed, (2) reconstructed, or (3) plugged under my jurisdiction and was completed on (mo/day/yr) 5/3/07 and this record is true to the best of my knowledge and belief. Kansas Water Well Contractor's License No. 616 This Water Well Record was completed on (mo/day/yr) 5/18/07
under the business name of Thiele Geotech, Inc. by (signature) [signature]

INSTRUCTIONS:. Please fill in blanks and circle the correct answers. Send three copies to Kansas Department of Health and Environment, Bureau of Water, 1000 S W Jackson St., Ste. 420, Topeka, Kansas 66612-1367. Telephone: 913-296-5545. Send one to WATER WELL OWNER and retain one for your records.

OFFICE USE ONLY T R SEC

Form provided by Forms-On-A-Disk, Inc. · Dallas, Texas · (214) 340-9429