


1 LOCATION OF WATER WELL: Fraction **SW 1/4 SW 1/4 SW 1/4** Section Number **26** Township Number **12 S** Range Number **24 E**  
 County: **Johnson**  
 Distance and direction from nearest town or city street address of well if located within city?  
**8633 Quivera Road, Lenexa, Kansas**

2 WATER WELL OWNER: **Conoco Phillips Company**  
 RR#, St. Address, Box # **1360 Phillips Bldg.** Board of Agriculture, Division of Water Resources  
 City, State, ZIP Code : **Bartlesville, OK 74004** Application Number:

3 MARK WELL'S LOCATON WITH AN "X" IN SECTION BOX:

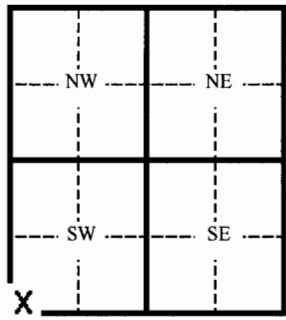

4 DEPTH OF WELL **15** ft.  
 WELL'S STATIC WATER LEVEL **2.46** ft.  
 WELL WAS USED AS:  
 1 Domestic 5 Public Water Supply 9 Dewatering  
 2 Irrigation 6 Oil Field Water Supply 10 Monitoring Well  
 3 Feedlot 7 Lawn and Garden (domestic) 11 Injection Well  
 4 Industrial 8 Air Conditioning 12 Other \_\_\_\_\_  
 Was a chemical/bacteriological sample submitted to Department? Yes \_\_\_\_\_ No **X**  
 If yes, mo/day/yr sample was submitted \_\_\_\_\_  
 Water Well Disinfected: Yes \_\_\_\_\_ No **X**

5 TYPE OF BLANK CASING USED:  
 1 Steel 3 RMP (SR) 5 Wrought 7 Fiberglass 9 Other (specify below)  
 2 **PVC** 4 ABC 6 Asbestos-Cement 8 Concrete Tile  
 Blank casing diameter **2** in. Was casing pulled? Yes **X** No \_\_\_\_\_ If yes, how much **pulled 3 feet of casing**  
 Casing height above or below land surface **approx. -6** in.

6 GROUT PLUG MATERIAL: 1 Neat cement 2 Cement grout 3 **Bentonite** 4 Other \_\_\_\_\_  
 Grout Plug Intervals From **3** ft. to **15** ft. From \_\_\_\_\_ ft. to \_\_\_\_\_ ft. From \_\_\_\_\_ ft. to \_\_\_\_\_ ft.  
 What is the nearest source of possible contamination:  
 1 Septic tank 6 Seepage pit 11 **Fuel storage** 16 Other (specify below)  
 2 Sewer lines 7 Pit privy 12 Fertilizer storage  
 3 Watertight sewer lines 8 Sewage lagoon 13 Insecticide storage  
 4 Lateral lines 9 Feedyard 14 Abandoned water well  
 5 Cess Pool 10 Livestock pens 15 Oil well/ Gas well

Direction from well? **southwest** How many feet? **approximately 150**

FROM	TO	CODE	PLUGGING MATERIALS
0	1		Concrete
1	3		Topsoil
3	15		Bentonite chips

7 CONTRACTOR'S OR LANDOWNER'S CERTIFICATION: This water well was plugged under my jurisdiction and was completed on (mo/day/yr) **10/30/07** and this record is true to the best of my knowledge and belief. Kansas Water Well Contractor's License No. **616** This Water Well Record was completed on (mo/day/yr) **11/6/07** under the business name of **Thiele Geotech, Inc.**  
 by (signature) *D. J. A. C.*

INSTRUCTIONS: Please fill in blanks and circle the correct answers. Send three copies to Kansas Department of Health and Environment, Bureau of Water, 1000 S W Jackson St., Ste. 420, Topeka, Kansas 66620-0001. Telephone: 785-296-3565. Send one to Water Well Owner and retain one for your records.