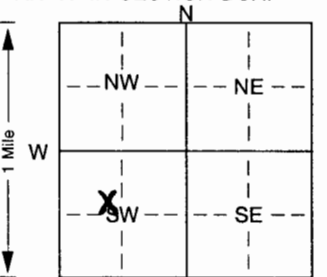


1 LOCATION OF WATER WELL: Fraction SE 1/4 NW 1/4 SW 1/4 Section Number 6 Township Number T 12 S Range Number R 24 EW
 County: JOHNSON
 Distance and direction from nearest town or city street address of well if located within city?

2 WATER WELL OWNER: JOHNSON COUNTY LAND FILL
 RR#, St. Address, Box #: 18181 W. 53RD ST
 City, State, ZIP Code: SHAWNEE, KS 66217
 Board of Agriculture, Division of Water Resources
 Application Number:

3 LOCATE WELL'S LOCATION WITH AN "X" IN SECTION BOX:

 4 DEPTH OF COMPLETED WELL: 159 ft. ELEVATION: 878.39
 Depth(s) Groundwater Encountered 1. _____ ft. 2. _____ ft. 3. _____ ft.
 WELL'S STATIC WATER LEVEL 145.21 ft. below land surface measured on mo/day/yr 6/5/06
 Pump test data: Well water was _____ ft. after _____ hours pumping _____ gpm
 Est. Yield _____ gpm: Well water was _____ ft. after _____ hours pumping _____ gpm
 Bore Hole Diameter: 6 in. to 15.9 ft., and _____ in. to _____ ft.
 WELL WATER TO BE USED AS: 5 Public water supply 8 Air conditioning 11 Injection well
 1 Domestic 3 Feedlot 6 Oil field water supply 9 Dewatering 12 Other (Specify below)
 2 Irrigation 4 Industrial 7 Domestic (lawn & garden) 10 Monitoring well M.W. - 64
 Was a chemical/bacteriological sample submitted to Department? Yes. _____ No. _____; If yes, mo/day/yr sample was submitted
 Water Well Disinfected? Yes _____ No _____

5 TYPE OF BLANK CASING USED:
 1 Steel 3 RMP (SR) 5 Wrought iron 8 Concrete tile CASING JOINTS: Glued. _____ Clamped. _____
2 PVC 4 ABS 6 Asbestos-Cement 9 Other (specify below) Welded _____
 7 Fiberglass Threaded _____
 Blank casing diameter 2 in. to 13.4 ft., Dia. _____ in. to _____ ft., Dia. _____ in. to _____ ft.
 Casing height above land surface _____ in., weight _____ lbs./ft. Wall thickness or gauge No. Sched. 80
 TYPE OF SCREEN OR PERFORATION MATERIAL:
 1 Steel 3 Stainless steel 5 Fiberglass 7 PVC 10 Asbestos-cement
 2 Brass 4 Galvanized steel 6 Concrete tile 8 RMP (SR) 11 Other (specify) _____
 9 ABS 12 None used (open hole)
 SCREEN OR PERFORATION OPENINGS ARE:
 1 Continuous slot 3 Mill slot 5 Gauzed wrapped 8 Saw cut 11 None (open hole)
 2 Louvered shutter 4 Key punched 6 Wire wrapped 9 Drilled holes
 7 Torch cut 10 Other (specify) _____ ft.
 SCREEN-PERFORATED INTERVALS: From 13.4 ft. to 15.9 ft., From _____ ft. to _____ ft.
 From _____ ft. to _____ ft., From _____ ft. to _____ ft.
 GRAVEL PACK INTERVALS: From 12.7 ft. to 15.9 ft., From _____ ft. to _____ ft.
 From _____ ft. to _____ ft., From _____ ft. to _____ ft.

6 GROUT MATERIAL: 1 Neat cement 2 Cement grout 3 Bentonite slaps 4 Other BENTONITE GROUT
 Grout Intervals: From 11.9 ft. to 12.7 ft., From _____ ft. to _____ ft., From 16.0 ft. to 11.9 ft.
 What is the nearest source of possible contamination:
 1 Septic tank 4 Lateral lines 7 Pit privy 10 Livestock pens 14 Abandoned water well
 2 Sewer lines 5 Cess pool 8 Sewage lagoon 11 Fuel storage 15 Oil well/Gas well
 3 Watertight sewer lines 6 Seepage pit 9 Feedyard 12 Fertilizer storage 16 Other (specify below)
 13 Insecticide storage M.S.W. L.F.
 Direction from well? _____ How many feet? _____

FROM	TO	LITHOLOGIC LOG	FROM	TO	PLUGGING INTERVALS
0	3.0	Gravel & Fill	159.0		STARK shale
3.0	12.0	ARGENTINE LS			
12.0	56.0	LAME SH			
56.0	64.0	ROYTOWN LS			
64.0	66.0	MUNICIPAL CREEK SH			
66.0	68.0	POOLA LS			
68.0	82.0	CHAUVE SH			
82.0	90.0	DRUM LS			
90.0	100.0	QUIVIRA SH			
100.0	111.0	WESTERVILLE LS			
111.0	125.0	WEA SH			
125.0	126.0	BLACK LS			
126.0	131.0	FONTANA SH			
131.0	159.0	WINTHROP LS			

7 CONTRACTOR'S OR LANDOWNER'S CERTIFICATION: This water well was (1) constructed, (2) reconstructed, or (3) plugged under my jurisdiction and was completed on (mo/day/year) 4/25/06 and this record is true to the best of my knowledge and belief. Kansas Water Well Contractor's Licence No. 650 This Water Well Record was completed on (mo/day/yr) 1/28/08 under the business name of DFS by (signature) [Signature]