

County: Johnson Fraction: SW SW SE Sec. 27 T. 12 S R. 24 E

CORRECTION(S) to WATER WELL COMPLETION RECORD Form WWC-5 (to rectify lacking or incorrect information)

Owner: Shell Oil Products MW 14

If location corrected, was listed as:

Section-Township-Range: 33-12-24E

Fraction (¼ calls): NW NW NW NE

Location changed to:

27-12-24E

SW SW SE

Other changes: Initial statements: Latitude 38.9706 Longitude -94.7301

Changed to: Latitude 38.971215 Longitude -94.732431

Comments: added elevation 1035.09

Verification method: Lat/Long & Section corrected using footages reported on Legal Survey & LeoWeb, and Site Map received from KDHE.

Initials: DLS Date: 01/06/2022

Submitted by: ☒ Kansas Geological Survey, Data Resources Library, 1930 Constant Ave., Lawrence, KS 66047-3724
☐ Kansas Dept. of Health & Environment, Bureau of Water, 1000 SW Jackson, Suite 420, Topeka, KS 66612-1367

DENNIS L HANDKE

1326 NW GUDEN STREET

TOPEKA, KANSAS 66618

785-286-1990 Fax

785-217-5864 Cell

785-286-4047 Home

Rick Horner

November 2, 2010

URS Corporation

8300 College Blvd., Suite 200

Overland Park, Kansas, 66210

RE: Monitor Well Elevation Survey

8700 Long Street, Lenexa, Kansas

Proj. 10-00AA

U4-046-13893

Shell Station

Bench Mark: Square cut on NE corner of concrete vacuum pad West of building.

Elev: 1052.50

North 5128.00

West 2200.00

(from SE Cor. Sec. 34-12-24)

MW-13	rim	1053.08	North 4975.00	West 2286.00	NE1/4,NW1/4,NW1/4,NE/14
	top pipe	1052.52			Lat = 38-58-13 Long = 94-43-53
MW-14	rim	1035.09	North 5374.00	West 2508.00	SW1/4,SW1/4,SW1/4,SE/14
	top pipe	1034.84			Lat = 38-58-14 Long = 94-43-55
					(Sec. 27-12-24)
MW-15	rim	1051.46	North 5136.00	West 2327.00	NW1/4,NW1/4,NW1/4,NE/14
	top pipe	1051.06			Lat = 38-58-15 Long = 94-43-55
MW-16	rim	1050.89	North 5183.00	West 2337.00	NW1/4,NW1/4,NW1/4,NE/14
	top pipe	1050.19			Lat = 38-58-16 Long = 94-43-56


*use footages to calculate
decimal degrees*

*Wells locate incorrectly using above degrees,
Seconds may be a typo, note they equal the
MW #s. Used footages to calculate location
for KGS WWC5 database.
DebS KGS 1/6/2022*

Elevation derived from existing project.

If you have any questions, please feel free to call me. Thank you for the opportunity to be of service to you.

Dennis L Handke

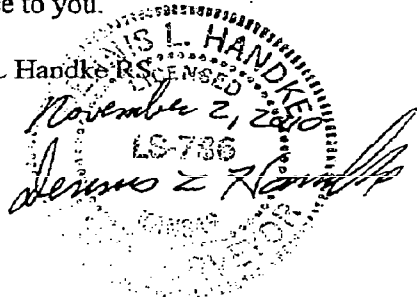

NOTE: Figures exhibited within this report are only to be used within the context of this report. Placement of property lines, wells, structures, and roads is based on the available information from county appraiser maps, surveys, site visits, and/or previous vendor reports and should be considered approximate.

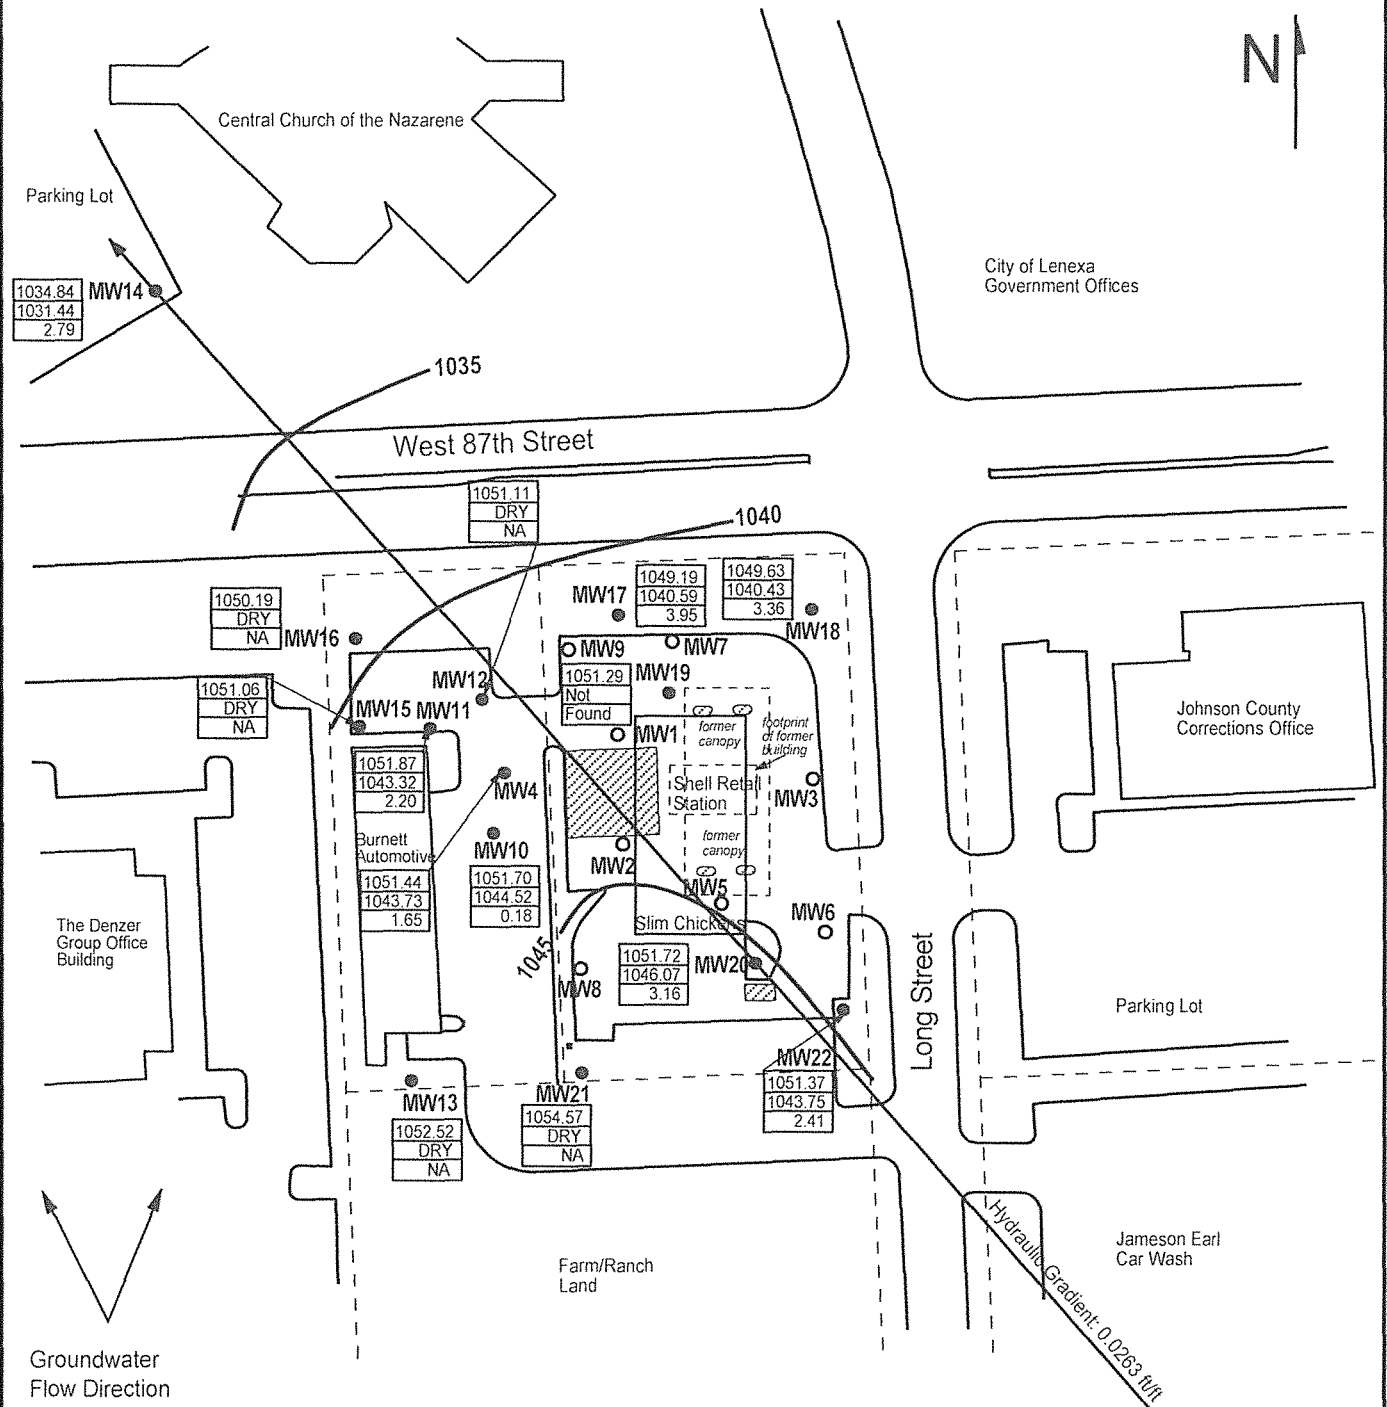


FIGURE 1 - GROUNDWATER FLOW MAP



PROJECT:
Shell Retail Gasoline Station
8700 Long
Lenexa, KS
KDHE ID: U4-046-13893
Date: 7/15/21

1311 E 25th St., Suite B (785) 841-8707 office
Lawrence, KS 66046 (785) 865-4282 fax

0 100 ft

LEGEND:

- Approximate Location of Former UST Basin and Pump Islands
- Approximate Location of Property Lines
- Monitoring Well
- Destroyed Well
- Casing Elevation (AMSL)
- Groundwater Elevation (AMSL)
- Elevation Change (FT)
- Equipotential Line (AMSL)

NOTE: Benchmark location is unknown.
NOTE: Approximate location of product lines is unknown.