

#MW8B

## WATER WELL PLUGGING RECORD Form WWC-5P KSA 82a-1212 ID NO.

1 LOCATION OF WATER WELL: Fraction NE 1/4 SW 1/4 NW 1/4 Section Number 6 Township Number T 12 S Range Number 234 ☒ E ☐ W  
County: Johnson

Street/Rural Address of Well Location; if unknown, distance & direction from nearest town or intersection: If at owner's address, check here ☒

## Global Positioning Systems (GPS) information:

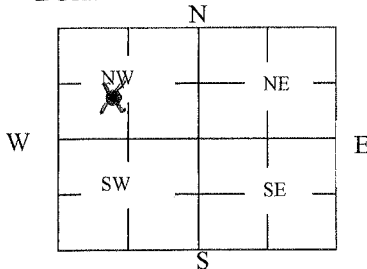
Latitude: 39.03995 (in decimal degrees)Longitude: -94.79495 (in decimal degrees)Elevation: 885Datum: ☐ WGS84, ☒ NAD83, ☐ NAD27

## Collection Method:

☐ GPS unit (Make/Model: \_\_\_\_\_)☐ Digital Map/Photo, ☐ Topographic Map, ☒ Land SurveyEst. Accuracy: ☒ < 3 m, ☐ 3-5 m, ☐ 5-15 m, ☐ > 15 m

2 WATER WELL OWNER: Deffenbaugh Industries  
RR#, St. Address, Box #: PO Box 3220  
City, State ZIP Code: Shawnee, KS 66203

## 3 MARK WELL'S LOCATION WITH AN "X" IN SECTION BOX:

4 DEPTH OF WELL 49 ft.WELL'S STATIC WATER LEVEL 44 ft

## WELL WAS USED AS:

☐ Domestic  
☐ Irrigation  
☐ Feedlot  
☐ Industrial

☐ Public Water Supply  
☐ Oil Field Water Supply  
☐ Domestic (Lawn & Garden)  
☐ Air Conditioning

☐ Dewatering  
☒ Monitoring  
☐ Injection Well  
☐ Other \_\_\_\_\_

Was a chemical/bacteriological sample submitted to Department? Yes ☐ No ☒

## 5 TYPE OF BLANK CASING USED:

☒ Steel  
☒ PVC

☐ RMP (SR)  
☐ ABS

☐ Wrought  
☐ Asbestos-Cement

☐ Fiberglass  
☐ Concrete Tile

☐ Other (Specify below) \_\_\_\_\_

Blank casing diameter 2 in. Was casing pulled? Yes ☒ No ☐ If yes, how much All of it  
Casing height above or below land surface \_\_\_\_\_ in.

## 6 GROUT PLUG MATERIAL:

☐ Neat cement☐ Cement grout☒ Bentonite☐ Other \_\_\_\_\_Grout Plug Intervals: From 0 ft. to 50 ft., From \_\_\_\_\_ ft. to \_\_\_\_\_ ft., From \_\_\_\_\_ to \_\_\_\_\_ ft.

What is the nearest source of possible contamination:

☐ Septic tank  
☐ Sewer lines  
☐ Watertight sewer lines  
☐ Lateral lines  
☐ Cess pool

☐ Seepage pit  
☐ Pit privy  
☐ Sewage lagoon  
☐ Feedyard  
☐ Livestock pens

☐ Fuel Storage  
☐ Fertilizer storage  
☐ Insecticide storage  
☐ Abandoned water well  
☐ Oil well/Gas well

☒ Other (specify below)  
MW is at the LF \_\_\_\_\_

Direction from well? \_\_\_\_\_  
How many feet? \_\_\_\_\_

FROM	TO	PLUGGING MATERIALS	FROM	TO	PLUGGING MATERIALS
0	50	Benseal EZ Mud Grout			

Original Returned to Sender

for Correction Date: 6-10-11

7 CONTRACTOR'S OR LANDOWNER'S CERTIFICATION: This water well was plugged under my jurisdiction and was completed on (mo/day/year) 4-14-2011 and this record is true to the best of my knowledge and belief. Kansas Water Well Contractor's License No. 570. This Water Well Record was completed on (mo/day/year) 5-25-2011 under the business name of Aquadrill a Terracon Company by (signature) [Signature]

INSTRUCTIONS: Use typewriter or ballpoint pen. Please press firmly and print clearly. Please fill in blanks, underline or circle the correct answers. Send top three copies to Kansas Department of Health and Environment, Bureau of Water, Geology Section, 1000 SW Jackson St., Ste. 420, Topeka, Kansas 66612-1367. Telephone: 785/296-5524. Send one to Water Well Owner and retain one for your records. Visit us at <http://www.kdheks.gov/waterwell/index.html>.

Check one: ☒ White Copy ☐ Blue Copy ☐ Pink Copy