WATER WELL PLUGGING RECORD Form WWC-5P KSA 82a-1212 ID NO.

1 LOCATION OF WATER WELL: County: Johnson | Fraction: SW ¼ SE¼SE ¼SE ¼ | Section Number: 36 | Township Number: T 12 S | Range Number: 24 ☒ E ☐ W

Street/Rural Address of Well Location; if unknown, distance & direction from nearest town or intersection: If at owner's address, check here ☐ 8940 W. 95th St.; Overland Park, KS

Global Positioning Systems (GPS) information:
Latitude: 38.9572 (in decimal degrees)
Longitude: 94.6900 (in decimal degrees)
Elevation:
Datum: ☐ WGS84, ☑ NAD83, ☐ NAD27
Collection Method:
☑ GPS unit (Make/Model: Garmin etrek
☐ Digital Map/Photo, ☐ Topographic Map, ☐ Land Survey
Est. Accuracy: ☐ < 3 m, ☒ 3-5 m, ☐ 5-15 m, ☐ > 15 m

2 WATER WELL OWNER: BP Products NA, Inc. c/o Angela Dunn
RR#, St. Address, Box #: 150 St. Peters Centre Blvd.
City, State ZIP Code: St. Peters MO 63376 Stc

3 MARK WELL'S LOCATION WITH AN "X" IN SECTION BOX:

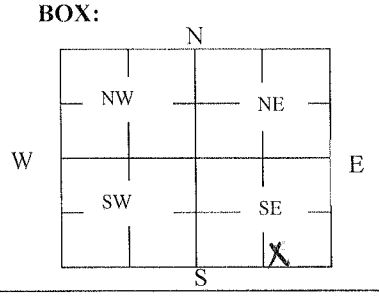

4 DEPTH OF WELL 13 ft.
WELL'S STATIC WATER LEVEL _____ ft
WELL WAS USED AS:

☐ Domestic	☐ Public Water Supply	☐ Dewatering
☐ Irrigation	☐ Oil Field Water Supply	☑ Monitoring
☐ Feedlot	☐ Domestic (Lawn & Garden)	☐ Injection Well
☐ Industrial	☐ Air Conditioning	☐ Other _____

Was a chemical/bacteriological sample submitted to Department? Yes ☐ No ☑

5 TYPE OF BLANK CASING USED:

☐ Steel	☐ RMP (SR)	☐ Wrought	☐ Fiberglass	☐ Other (Specify below)
☑ PVC	☐ ABS	☐ Asbestos-Cement	☐ Concrete Tile	

Blank casing diameter 2 in. Was casing pulled? Yes ☑ No ☐ If yes, how much All
Casing height above or below land surface 6 in.

6 GROUT PLUG MATERIAL: ☐ Neat cement ☐ Cement grout ☑ Bentonite ☐ Other _____

Grout Plug Intervals: From 3 ft. to 13 ft., From — ft. to — ft., From — to — ft.

What is the nearest source of possible contamination:

☐ Septic tank	☐ Seepage pit	☒ Fuel Storage	☐ Other (specify below)
☐ Sewer lines	☐ Pit privy	☐ Fertilizer storage	
☐ Watertight sewer lines	☐ Sewage lagoon	☐ Insecticide storage	
☐ Lateral lines	☐ Feedyard	☐ Abandoned water well	Direction from well? West
☐ Cess pool	☐ Livestock pens	☐ Oil well/Gas well	How many feet? 60

FROM	TO	PLUGGING MATERIALS	FROM	TO	PLUGGING MATERIALS
0	1	concrete/asphalt surface			
1	3	top soil			
3	13	bentonite			

7 CONTRACTOR'S OR LANDOWNER'S CERTIFICATION: This water well was plugged under my jurisdiction and was completed on (mo/day/year) May 4, 2012 and this record is true to the best of my knowledge and belief. Kansas Water Well Contractor's License No. 710. This Water Well Record was completed on (mo/day/year) May 8, 2012 under the business name of Below Ground Surface, Inc. by (signature) _____

INSTRUCTIONS: Use typewriter or ballpoint pen. Please press firmly and print clearly. Please fill in blanks, underline or circle the correct answers. Send top three copies to Kansas Department of Health and Environment, Bureau of Water, Geology Section, 1000 SW Jackson St., Ste. 420, Topeka, Kansas 66612-1367. Telephone: 785/296-5524. Send one to Water Well Owner and retain one for your records. Visit us at http://www.kdheks.gov/waterwell/index.html.

Check one: ☐ White Copy ☐ Blue Copy ☐ Pink Copy