

WATER WELL RECORD

Form WWC-5

Division of Water Resources App. No.


1 LOCATION OF WATER WELL: Fraction NW SE SW W

County: Johnson Section Number 34 Township No. T 12 S Range Number R 24 E

Street/Rural Address of Well Location; if unknown, distance & direction from nearest town or intersection: If at owner's address, check here 12930 W. 95th St. Lenexa, KS.

Global Positioning System (GPS) information:
 Latitude: 38.572408 (in decimal degrees)
 Longitude: 94.440951 (in decimal degrees)
 Elevation:
 Datum: WGS 84, NAD 83, NAD 27
 Collection Method: GPS unit (Make/Model: Google Earth)
 Digital Map/Photo, Topographic Map, Land Survey
 Est. Accuracy: <3 m, 3-5 m, 5-15 m, >15 m

2 WATER WELL OWNER: Cuda Holdings, LLC.
 RR#, Street Address, Box #: 7915 N. Oak. Tr. Highway
 City, State, ZIP Code: Kansas City, Mo. 64118

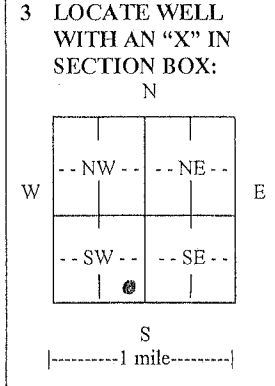

4 DEPTH OF COMPLETED WELL 13'4" ft.
 Depth(s) Groundwater Encountered (1)..... ft. (2)..... ft. (3)..... ft.
 WELL'S STATIC WATER LEVEL 5:33 ft. below land surface measured on mo/day/yr. 4/16/14
 Pump test data: Well water wasft. after hours pumping gpm
 EST. YIELD.....gpm Well water wasft. after hours pumping gpm
 Bore Hole Diameter 1.5" in. to 13'4" ft., andin. toft.
 WELL WATER TO BE USED AS: Public water supply Geothermal Injection well
 Domestic Feedlot Oil field water supply Dewatering Other (Specify below)
 Irrigation Industrial Domestic-lawn & garden Monitoring well
 Was a chemical/bacteriological sample submitted to Department? Yes No
 If yes, mo/day/yr sample was submitted.....
 Water well disinfected? Yes No

5 TYPE OF CASING USED: Steel PVC Other
 CASING JOINTS: Glued Clamped Welded Threaded
 Casing diameter 2.375 in. to 3' ft. Diameter in. to ft., Diameter in. to ft.
 Casing height above land surface Flush in., Weightlbs./ft., Wall thickness or gauge No. 3ch40
 TYPE OF SCREEN OR PERFORATION MATERIAL:
 Steel Stainless Steel PVC Other (Specify)
 Brass Galvanized Steel None used (open hole)
 SCREEN OR PERFORATION OPENINGS ARE:
 Continuous slot Mill slot Gauze wrapped Torch cut Drilled holes None (open hole)
 Louvered shutter Key punched Wire wrapped Saw cut, Other (specify)
 SCREEN-PERFORATED INTERVALS: From 13' ft. to 3' ft., From ft. to ft.
 From ft. to ft., From ft. to ft.
 GRAVEL PACK INTERVALS: From 13'4" ft. to 2' ft., From ft. to ft.
 From ft. to ft., From ft. to ft.

6 GROUT MATERIAL: Neat cement Cement grout Bentonite Other concrete
 Grout Intervals: From 2' ft. to 1' ft., From 1' ft. to 0' ft., From ft. to ft.
 What is the nearest source of possible contamination:
 Septic tank Lateral lines Pit privy Livestock pens Insecticide storage Other (specify below)
 Sewer lines Cesspool Sewage lagoon Fuel storage Four Abandoned water well
 Watertight sewer lines Seepage pit Feedyard Fertilizer storage Oil well/gas well
 Direction from well North Distance from well 40'

FROM	TO	LITHOLOGIC LOG	FROM	TO	LITHO. LOG (cont.) or PLUGGING INTERVALS
0	1.50	Concrete			
1.50	3.0	Black Clay			
3.0	9.0	blue Binley w/ pyroxides			
9.0	11.5	yellowish Bin weathered shale			
11.5	13.4"	Limestone - weathered			

7 CONTRACTOR'S OR LANDOWNER'S CERTIFICATION: This water well was constructed, reconstructed, or plugged under my jurisdiction and was completed on (mo/day/year) 4/3/14 and this record is true to the best of my knowledge and belief.
 Kansas Water Well Contractor's License No. 732 This Water Well Record was completed on (mo/day/year) 4/20/14
 under the business name of JB Environmental by (signature) James Baker

INSTRUCTIONS: Use typewriter or ball point pen. PLEASE PRESS FIRMLY and PRINT clearly. Please fill in blanks and check the correct answers. Send one copy to Kansas Department of Health and Environment, Bureau of Water, Geology Section, 1000 SW Jackson St., Suite 420, Topeka, Kansas 66612-1367. Telephone 785-296-5524. Send one copy to WATER WELL OWNER and retain one for your records. Include fee of \$5.00 for each constructed well. Visit us at <http://www.kdheks.gov/waterwell/index.html>