

WATER WELL PLUGGING RECORD Form WWC-5P

KSA 82a-1212

ID NO.


11W-2

1 LOCATION OF WATER WELL: Fraction SW 1/4 SE 1/4 SE 1/4 SW 1/4 Section Number 34 Township Number T 12 S Range Number 24 E W
 County: Johnson

Street/Rural Address of Well Location; if unknown, distance & direction from nearest town or intersection: If at owner's address, check here Fuel Max
12930 West 95th St., Lenexa

Global Positioning Systems (GPS) information:
 Latitude: 38.9568 (in decimal degrees)
 Longitude: 94.7360 (in decimal degrees)
 Elevation: 1024.42
 Datum: WGS84, NAD83, NAD27
 Collection Method:
 GPS unit (Make/Model): _____
 Digital Map/Photo, Topographic Map, Land Survey
 Est. Accuracy: < 3 m, 3-5 m, 5-15 m, > 15 m

2 WATER WELL OWNER: Cuda Holdings, LLC
 RR#, St. Address, Box #: 7915 N. Oak Trafficway
 City, State ZIP Code: Kansas City, MO 64118

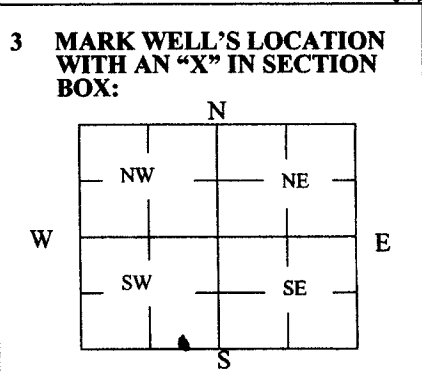

4 DEPTH OF WELL 13.30 ft.
WELL'S STATIC WATER LEVEL 2.73 ft
WELL WAS USED AS:
 Domestic Public Water Supply Dewatering
 Irrigation Oil Field Water Supply Monitoring
 Feedlot Domestic (Lawn & Garden) Injection Well
 Industrial Air Conditioning Other _____
 Was a chemical/bacteriological sample submitted to Department? Yes No

5 TYPE OF BLANK CASING USED:
 Steel RMP (SR) Wrought Fiberglass Other (Specify below)
 PVC ABS Asbestos-Cement Concrete Tile
 Blank casing diameter 2 in. Was casing pulled? Yes No If yes, how much 3 ft. (cut)
 Casing height above or below land surface -6.12 in.

6 GROUT PLUG MATERIAL: Neat cement Cement grout Bentonite Other _____
 Grout Plug Intervals: From 13.30 ft. to 3 ft., From _____ ft. to _____ ft., From _____ ft. to _____ ft.
 What is the nearest source of possible contamination:
 Septic tank Seepage pit Fuel storage Other (specify below)
 Sewer lines Pit privy Fertilizer storage
 Watertight sewer lines Sewage lagoon Insecticide storage
 Lateral lines Feedyard Abandoned water well Direction from well? West
 Cess pool Livestock pens Oil well/Gas well How many feet? 40

FROM	TO	PLUGGING MATERIALS	FROM	TO	PLUGGING MATERIALS
13.30	3	Hydrated chip bentonite			
3	0	Topsoil			

7 CONTRACTOR'S OR LANDOWNER'S CERTIFICATION: This water well was plugged under my jurisdiction and was completed on (mo/day/year) 1/29/16 and this record is true to the best of my knowledge and belief. Kansas Water Well Contractor's License No. _____ This Water Well Record was completed on (mo/day/year) 2/9/16 under the business name of Knightsy Environmental Inc. by (signature) [Signature]

INSTRUCTIONS: Use typewriter or ballpoint pen. Please press firmly and print clearly. Please fill in blanks, underline or circle the correct answers. Send top three copies to Kansas Department of Health and Environment, Bureau of Water, Geology Section, 1000 SW Jackson St., Ste. 420, Topeka, Kansas 66612-1367. Telephone: 785/296-5524. Send one to Water Well Owner and retain one for your records. Visit us at <http://www.kdheks.gov/waterwell/index.html>.