

WATER WELL PLUGGING RECORD Form WWC-5P

KSA 82a-1212

ID NO.

C-1


| | | | | |
|--|--|-----------------------------|----------------------------------|--|
| 1 LOCATION OF WATER WELL: County: Johnson | Fraction $\frac{1}{4}$ sw $\frac{1}{4}$ se $\frac{1}{4}$ sw $\frac{1}{4}$ | Section Number 25 | Township Number T 12 S | Range Number 24 <input checked="" type="checkbox"/> E <input type="checkbox"/> W |
|--|--|-----------------------------|----------------------------------|--|

Street/Rural Address of Well Location; if unknown, distance & direction from nearest town or intersection: If at owner's address, check here **West Park, LLC**
5201 Johnson Drive, Ste. 100
Mission, KS 66205

Global Positioning Systems (GPS) information:
 Latitude: **38.97143** (in decimal degrees)
 Longitude: **-94.69855** (in decimal degrees)
 Elevation: **1050**
 Horizontal Datum: WGS84, NAD83, NAD27
 Collection Method:

2 WATER WELL OWNER: West Shopping Center
 RR#, St. Address, Box #: **9700 W. 87th St.**
 City, State ZIP Code: **Overland Park, KS 66212**

GPS unit (Make/Model: _____)
 Digital Map/Photo, Topographic Map, Land Survey
 Est. Accuracy: < 3 m, 3-5 m, 5-15 m, > 15 m

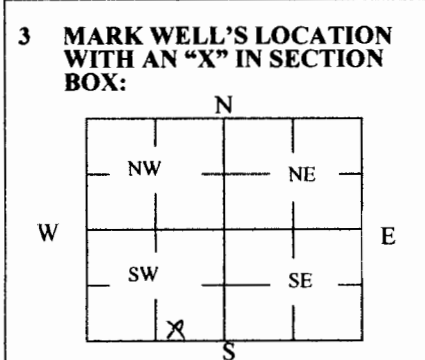

4 DEPTH OF WELL 15.0 ft.
 WELL'S STATIC WATER LEVEL 8.22 ft
 WELL WAS USED AS:
 Domestic Public Water Supply Dewatering
 Irrigation Oil Field Water Supply Monitoring
 Feedlot Domestic (Lawn & Garden) Injection Well
 Industrial Air Conditioning Other C-1
 Was a chemical/bacteriological sample submitted to Department? Yes No

5 TYPE OF BLANK CASING USED:

Steel RMP (SR) Wrought Fiberglass Other (Specify below) _____
 PVC ABS Asbestos-Cement Concrete Tile

Blank casing diameter 2 in. Was casing pulled? Yes No If yes, how much _____
 Casing height above or below land surface 0 in.

6 GROUT PLUG MATERIAL: Neat cement Cement grout Bentonite Other _____

Grout Plug Intervals: From 3 ft. to 15.0 ft., From N/A ft. to N/A ft., From N/A ft. to N/A ft.

What is the nearest source of possible contamination:

| | | | |
|---|---|--|--|
| <input type="checkbox"/> Septic tank | <input type="checkbox"/> Seepage pit | <input checked="" type="checkbox"/> Fuel storage | <input type="checkbox"/> Other (specify below) _____ |
| <input type="checkbox"/> Sewer lines | <input type="checkbox"/> Pit privy | <input type="checkbox"/> Fertilizer storage | |
| <input type="checkbox"/> Watertight sewer lines | <input type="checkbox"/> Sewage lagoon | <input type="checkbox"/> Insecticide storage | |
| <input type="checkbox"/> Lateral lines | <input type="checkbox"/> Feedyard | <input type="checkbox"/> Abandoned water well | Direction from well? <u>Adjacent</u> |
| <input type="checkbox"/> Cess pool | <input type="checkbox"/> Livestock pens | <input type="checkbox"/> Oil well/Gas well | How many feet? <u>20-feet</u> |

| FROM | TO | PLUGGING MATERIALS | FROM | TO | PLUGGING MATERIALS |
|------|------|----------------------|------|----|--------------------|
| 0 | 3 | Concrete/topsoil | | | |
| 3 | 15.0 | Bentonite (hydrated) | | | |
| | | | | | |
| | | | | | |
| | | | | | |

7 CONTRACTOR'S OR LANDOWNER'S CERTIFICATION: This water well was plugged under my jurisdiction and was completed on (mo/day/year) 9/5/2018 and this record is true to the best of my knowledge and belief. Kansas Water Well Contractor's License No. 759. This Water Well Record was completed on (mo/day/year) 9/16/2018 under the business name of RAZEK Environmental, LLC by (signature) _____

Send one white copy to Kansas Department of Health & Environment, Geology Section, 1000 SW Jackson Street, Ste. 420, Topeka, KS 66612-1367. Send one copy to WATER WELL OWNER and retain one for your records.
 Visit us at <http://www.kdheks.gov/waterwell/index.html> Telephone 785-296-5524.

Johnson
18W SE SW
25 - 12 - 24 E
WEST PARK LLC



Potentiometric Surface Map
November 20, 2017
 West Park Shopping Center
 Voluntary Cleanup Investigation Report
 Overland Park, Johnson County, Kansas

The information included on this graphic representation has been compiled from a variety of sources and is subject to change without notice. Kleinfelder makes no representations or warranties, express or implied, as to accuracy, completeness, timeliness, or rights to the use of such information. This document is not intended for use as a land survey product nor is it designed or intended as a construction design document. The use or misuse of the information contained on this graphic representation is at the sole risk of the party using or misusing the information.

| | |
|-------------------|----------------|
| DRAWN: 08/2014 | REVISED: NA |
| DRAWN BY: AL | |
| CHECKED BY: BN | |
| FIGURE | 4 |

PROJECT NO: 131396 FILE NAME: X:\GIS_Database\Clients\KLF_Offices\Tulsa\131396_WestParkMKD\Report