


MW-2

Revised 7/10/2015

JOHNSON CO KDHE SENE NW SW 34-12-24E

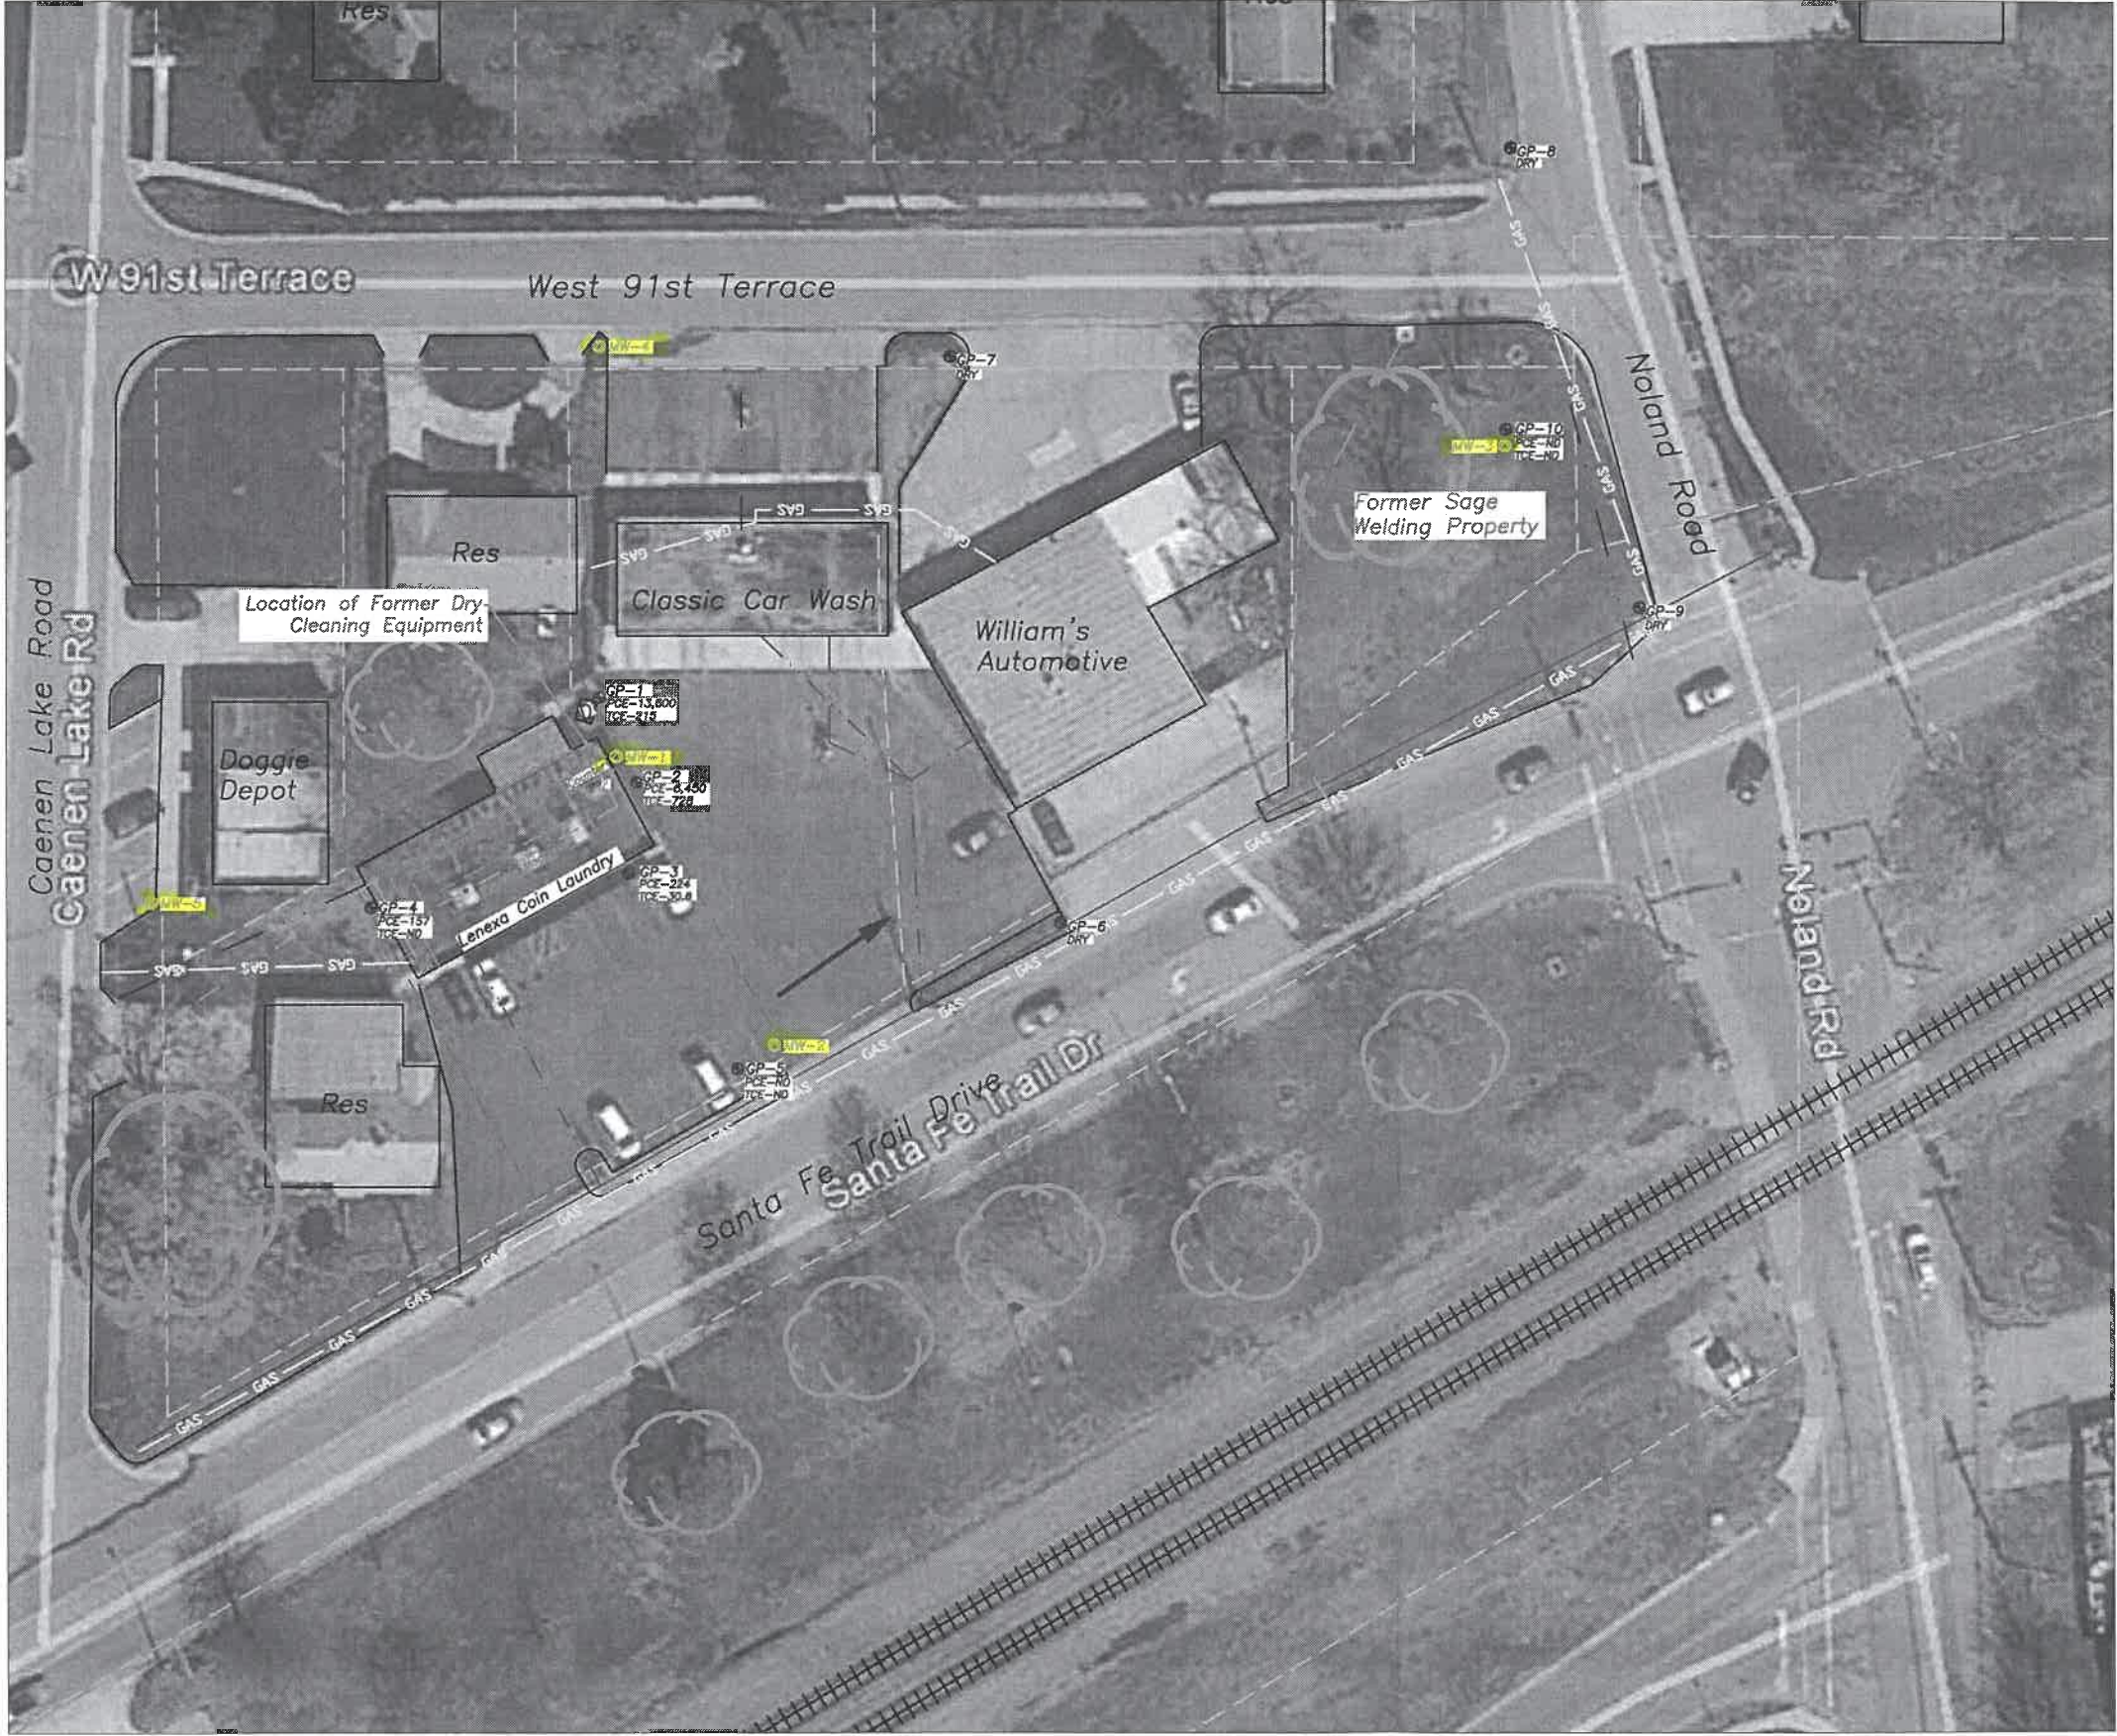

LEGEND:

- APPROXIMATE SITE BOUNDARY
- PARCEL LINE
- OVERHEAD POWER LINE
- WATER LINE (3-6')
- SEWER LINE (3-6')
- GAS LINE (2-5')
- GROUNDWATER FLOW DIRECTION (PRESUMED)
- TREE OR TREE COVER
- PROPOSED MONITORING WELL
- GROUNDWATER PROBE

PCE MARCH 2018 RESULTS IN UG/L
TCE

- NOTES:
1. LOCATION OF FORMER DRY CLEANING EQUIPMENT IS APPROXIMATE, BASED ON OWNER INTERVIEW.
 2. LOCATION OF PAST SITE INVESTIGATION SAMPLE LOCATIONS ARE APPROXIMATE, AND BASED ON PREVIOUS FIGURES PROVIDED BY KDHE.
 3. UTILITY LOCATIONS AND DEPTHS ARE APPROXIMATE, BASED ON SITE OBSERVATIONS, PREVIOUS FIGURES PROVIDED BY KDHE, AND/OR LIMITED PRIVATE UTILITY LOCATES.



FIGURE X - PROPOSED MONITORING WELLS		CLIENT: LENEXA COIN LAUNDRY C4-046-70277 13114 SANTA FE TRAIL DRIVE LENEXA, KANSAS		SCS ENGINEERS 7311 West 130th Street, Suite 100 Overland Park, Kansas 66213					
		DRAWN BY: LAM	DESIGNED BY: LAM			PROJECT WBS: SLM			
		ELECTRONIC FILE NAME: 27216328.00_CI_WP.DWG		DATE: 6/4/2018					
REV: 0	X	PROJECT NUMBER: 27216328.00				REV.	DATE	BY	DESCRIPTION
						R5		5BY	-
						R4		4BY	-
						R3		3BY	-
						R2		2BY	-
						R1		1BY	-
						RO		0BY	-

SMH CONSULTANTS

August 10, 2018

SCS Engineers
Leah A. Meyer
Senior Project Professional
7311 West 130th Street, Suite 100
Overland Park, Kansas 66213
Email: LMeyer@scsengineers.com

RE: Project No. 1807MN1196

Dear Leah:

The following is the information requested on a Monitoring Well Site, Lenexa Coin Laundry,
13114 Santa Fe Trail Drive, Lenexa, Johnson County, Kansas.

Point	North Coord.	East Coord.	Distance SE Cor. North	From S.34 West	Elev. Top Of Rim or PK Nail	Elev. Top of PVC Pipe	Latitude North	Longitude West
SE Corner S.34-T12S-R24E	40000	40000						
MW1	42144.47	35719.66	2144.47	4280.34	1056.74	1056.43	38.96236	94.73883
MW2	42069.91	35753.73	2069.91	4246.27	1055.29	1055.06	38.96218	94.73868
MW3	42216.71	35981.78	2216.71	4018.22	1047.00	1046.54	38.96259	94.73788
MW4	42251.81	35715.42	2251.81	4284.58	1056.29	1056.04	38.96269	94.73884
MW5	42105.54	35593.42	2105.54	4406.76	1061.51	1061.21	38.96227	94.73928
Site BM	42026.34	35713.31	2026.34	4286.69		BM Elevation = 1056.42		

BM Description: "□" cut on north end of curb return of west drive entrance.

MW1, MW2, MW4, MW5 are in the: SE¼ NE¼ NW¼ SW¼ S.34-T12S-R24E
MW3 is in the: SW¼ NE¼ NW¼ SW¼ S.34-T12S-R24E

If you have any questions, please do not hesitate in giving us a call.

Sincerely,



Tim Sloan, L.S.
SMH CONSULTANTS