


MW-4

Well ID

Revised 7/10/2015

JOHNSON CO KDHE SENE NW SW 34-12-24E
SW " "

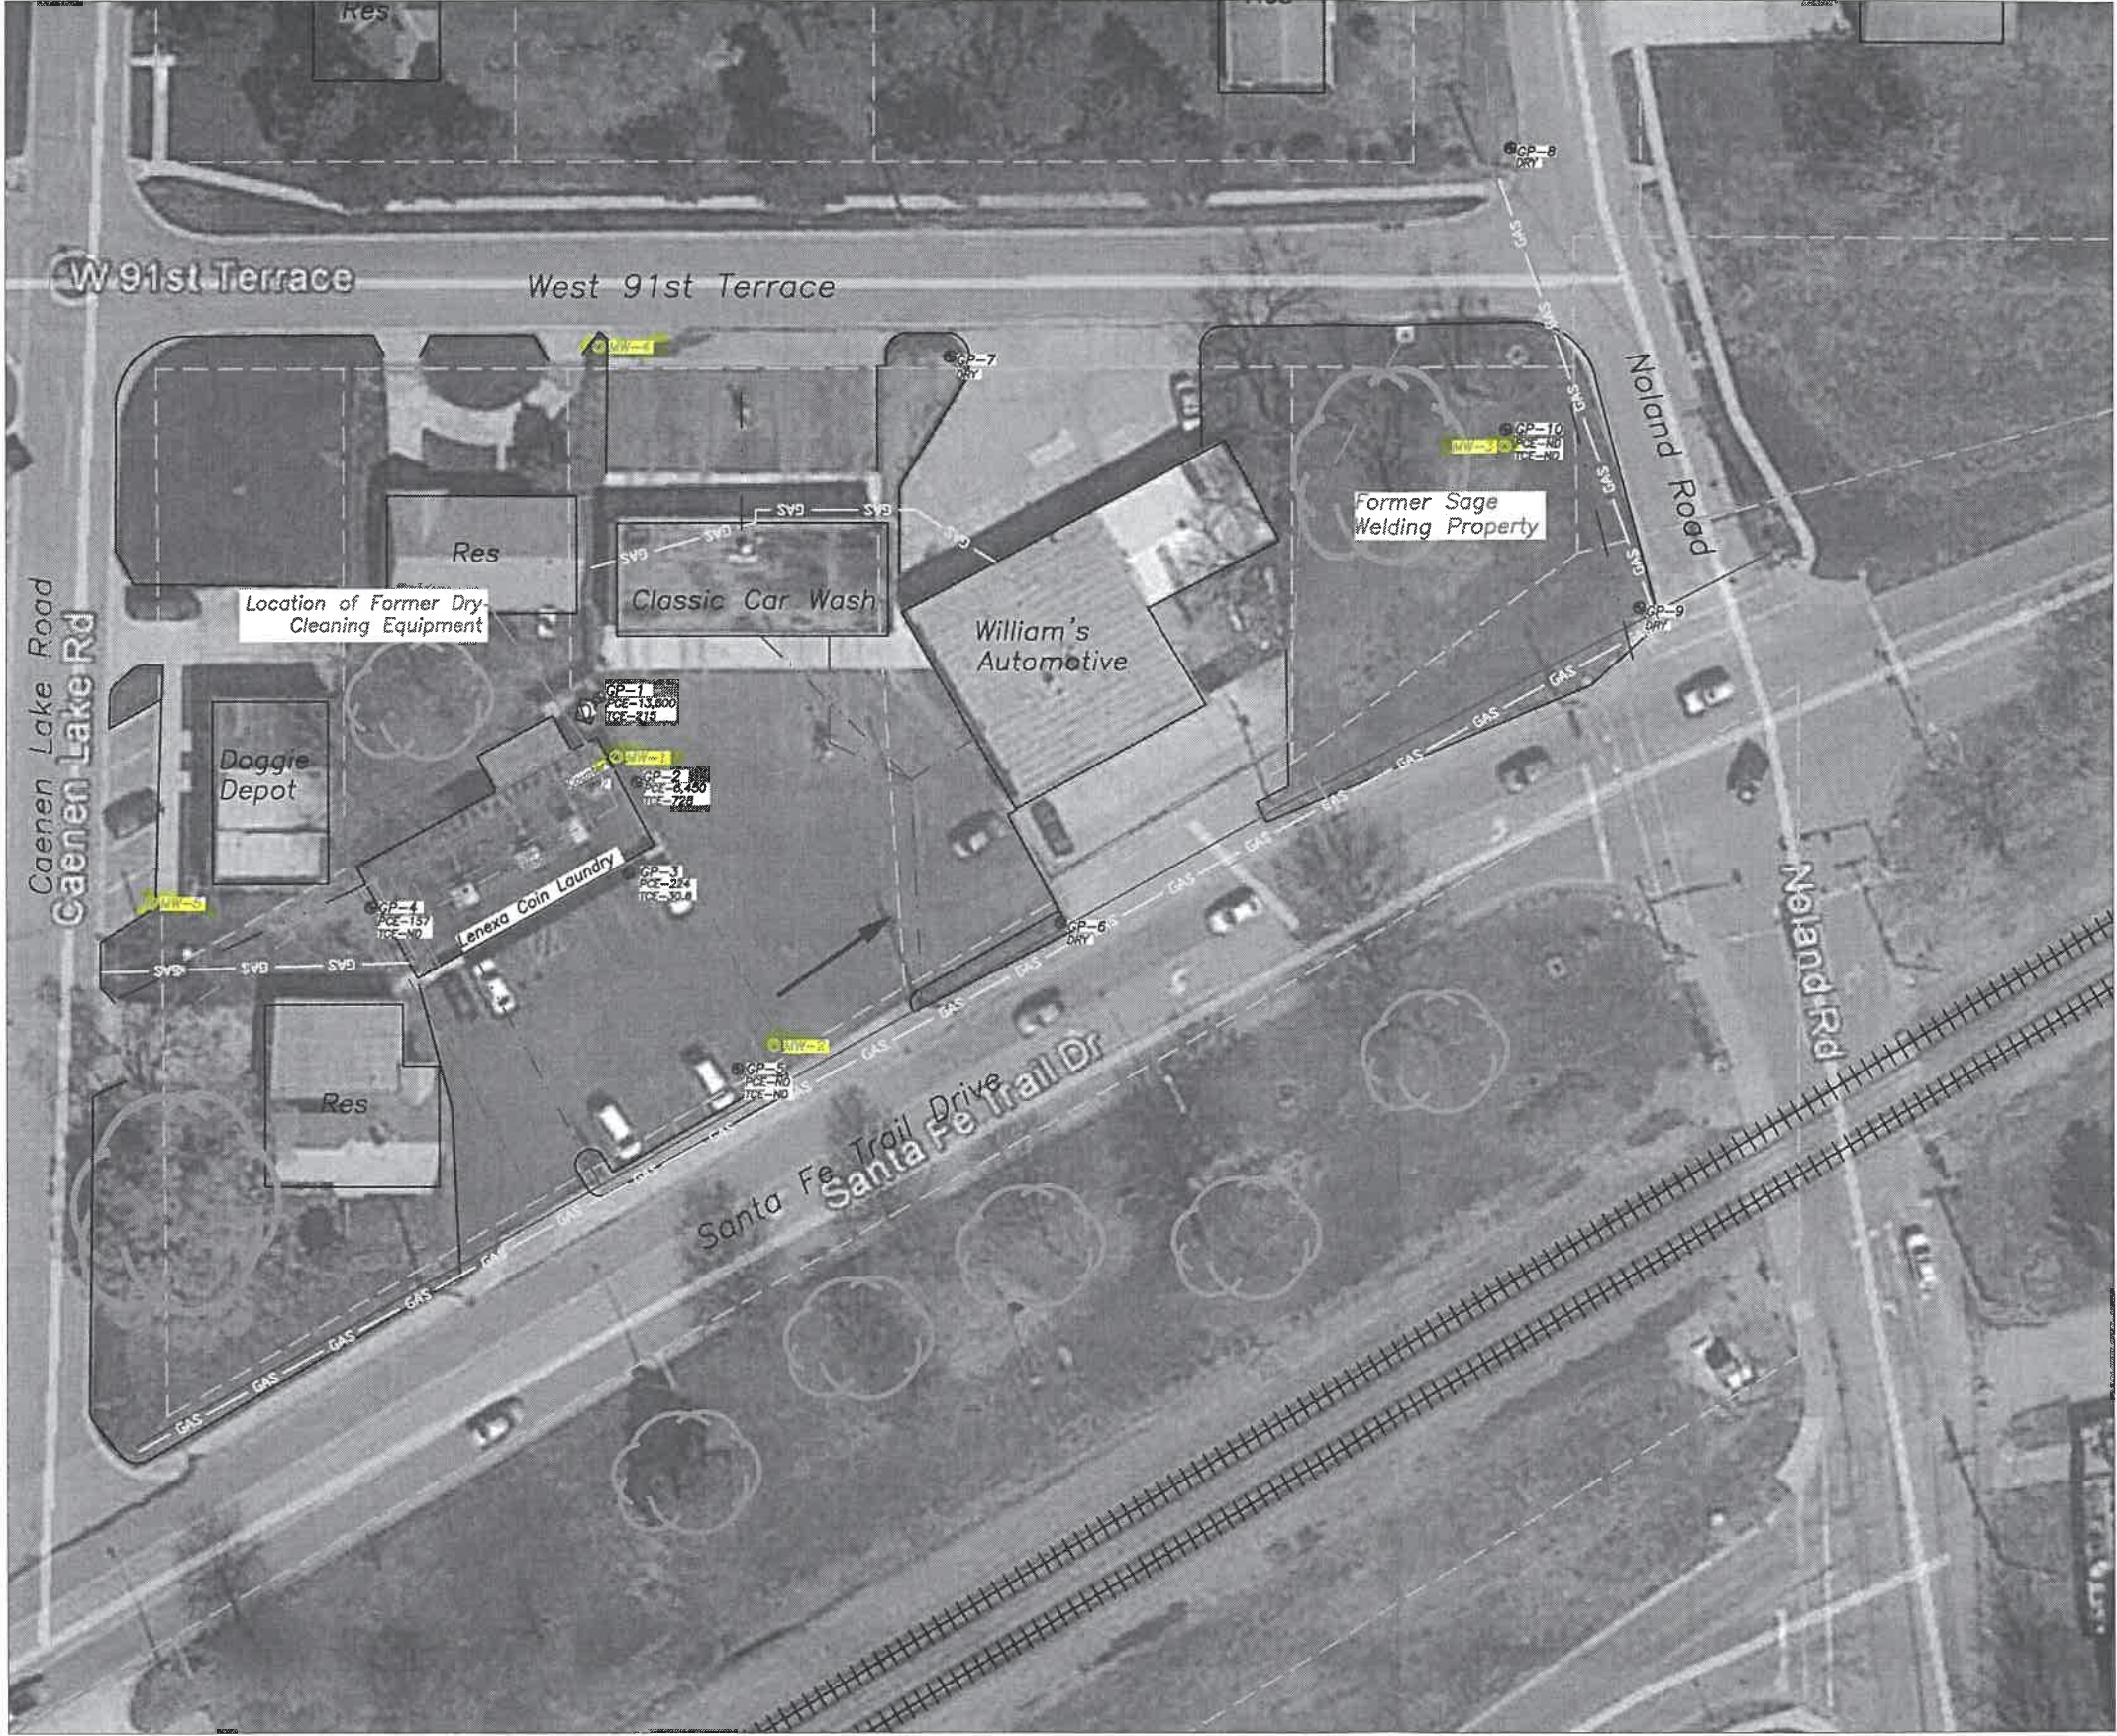

LEGEND:

- APPROXIMATE SITE BOUNDARY
- PARCEL LINE
- OVERHEAD POWER LINE
- WATER LINE (3-6')
- SEWER LINE (3-6')
- GAS LINE (2-5')
- GROUNDWATER FLOW DIRECTION (PRESUMED)
- TREE OR TREE COVER
- PROPOSED MONITORING WELL
- ⊕ GROUNDWATER PROBE

PCE MARCH 2018 RESULTS IN UG/L
TCE

- NOTES:
1. LOCATION OF FORMER DRY CLEANING EQUIPMENT IS APPROXIMATE, BASED ON OWNER INTERVIEW.
 2. LOCATION OF PAST SITE INVESTIGATION SAMPLE LOCATIONS ARE APPROXIMATE, AND BASED ON PREVIOUS FIGURES PROVIDED BY KDHE.
 3. UTILITY LOCATIONS AND DEPTHS ARE APPROXIMATE, BASED ON SITE OBSERVATIONS, PREVIOUS FIGURES PROVIDED BY KDHE, AND/OR LIMITED PRIVATE UTILITY LOCATES.



CLIENT: LENEXA COIN LAUNDRY C4-046-70277 13114 SANTA FE TRAIL DRIVE LENEXA, KANSAS		PROJECT NO: SLM		DATE: 6/4/2018	
DRAWN BY: LAM		DESIGNED BY: LAM		PROJECT NUMBER: 27216328.00	
ELECTRONIC FILE NAME: 27216328.00_CI_WP.DWG		PROJECT NUMBER: 27216328.00		PROJECT NUMBER: 27216328.00	
REV: 0		X		X	
FIGURE X - PROPOSED MONITORING WELLS		SCS ENGINEERS		7311 West 130th Street, Suite 100 Overland Park, Kansas 66213	
				REV. DATE BY DESCRIPTION	
				R5 5BY	
				R4 4BY	
				R3 3BY	
				R2 2BY	
				R1 1BY	
				R0 0BY	

SMH CONSULTANTS

August 10, 2018

SCS Engineers
Leah A. Meyer
Senior Project Professional
7311 West 130th Street, Suite 100
Overland Park, Kansas 66213
Email: LMeyer@scsengineers.com

RE: Project No. 1807MN1196

Dear Leah:

The following is the information requested on a Monitoring Well Site, Lenexa Coin Laundry,
13114 Santa Fe Trail Drive, Lenexa, Johnson County, Kansas.

Point	North Coord.	East Coord.	Distance SE Cor. North	From S.34 West	Elev. Top Of Rim or PK Nail	Elev. Top of PVC Pipe	Latitude North	Longitude West
SE Corner S.34-T12S-R24E	40000	40000						
MW1	42144.47	35719.66	2144.47	4280.34	1056.74	1056.43	38.96236	94.73883
MW2	42069.91	35753.73	2069.91	4246.27	1055.29	1055.06	38.96218	94.73868
MW3	42216.71	35981.78	2216.71	4018.22	1047.00	1046.54	38.96259	94.73788
MW4	42251.81	35715.42	2251.81	4284.58	1056.29	1056.04	38.96269	94.73884
MW5	42105.54	35593.42	2105.54	4406.76	1061.51	1061.21	38.96227	94.73928
Site BM	42026.34	35713.31	2026.34	4286.69		BM Elevation = 1056.42		

BM Description: "□" cut on north end of curb return of west drive entrance.

MW1, MW2, MW4, MW5 are in the: SE¼ NE¼ NW¼ SW¼ S.34-T12S-R24E
MW3 is in the: SW¼ NE¼ NW¼ SW¼ S.34-T12S-R24E

If you have any questions, please do not hesitate in giving us a call.

Sincerely,



Tim Sloan, L.S.
SMH CONSULTANTS