

1 LOCATION OF WATER WELL:	Fraction	Section Number	Township Number	Range Number
County: JOHNSON	SE ¼ NW ¼ SE ¼	3	T 12 S	R 25 EW

Distance and direction from nearest town or city street address of well if located within city?


2814 SHAWNEE MISSION PARKWAY, FAIRWAY, KANSAS

2 WATER WELL OWNER:	AMOCO OIL COMPANY
RR#, St. Address, Box # :	8700 INDIAN CREEK PARKWAY
City, State, ZIP Code :	OVERLAND PARK, KANSAS

Board of Agriculture, Division of Water Resources

Application Number:

3 LOCATE WELL'S LOCATION WITH AN "X" IN SECTION BOX:	4 DEPTH OF COMPLETED WELL 15.5 ft. ELEVATION:
--	---

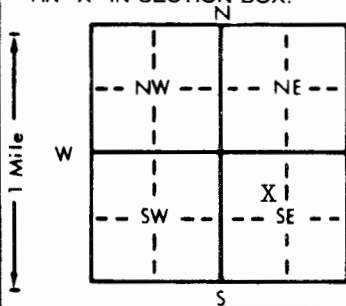

Depth(s) Groundwater Encountered 1.10, 21 ft. 2. ft. 3. ft.

WELL'S STATIC WATER LEVEL 7.31 ft. below land surface measured on mo/day/yr 5-22-90

Pump test data: Well water was ft. after hours pumping gpm

Est. Yield gpm: Well water was ft. after hours pumping gpm

Bore Hole Diameter 6 in. to 15.5 ft. and in. to ft.

WELL WATER TO BE USED AS: 5 Public water supply 8 Air conditioning 11 Injection well

1 Domestic 3 Feedlot 6 Oil field water supply 9 Dewatering 12 Other (Specify below)

2 Irrigation 4 Industrial 7 Lawn and garden only 10 Monitoring well

Was a chemical/bacteriological sample submitted to Department? Yes No X; If yes, mo/day/yr sample was submitted

Water Well Disinfected? Yes No X

5 TYPE OF BLANK CASING USED:	5 Wrought iron	8 Concrete tile	CASING JOINTS: Glued Clamped
1 Steel	3 RMP (SR)	6 Asbestos-Cement	9 Other (specify below)
2 PVC	4 ABS	7 Fiberglass	10 Asbestos-cement

Blank casing diameter 2 in. to 5.24 ft. Dia in. to ft. Dia in. to ft.

Casing height above land surface -24 ft. weight lbs./ft. Wall thickness or gauge No. SCHED. 40

TYPE OF SCREEN OR PERFORATION MATERIAL:	7 PVC	10 Asbestos-cement
1 Steel	3 Stainless steel	5 Fiberglass
2 Brass	4 Galvanized steel	6 Concrete tile

SCREEN OR PERFORATION OPENINGS ARE:	5 Gauzed wrapped	8 Saw cut	11 None (open hole)
1 Continuous slot	3 Mill slot	6 Wire wrapped	9 Drilled holes
2 Louvered shutter	4 Key punched	7 Torch cut	10 Other (specify)

SCREEN-PERFORATED INTERVALS: From 5.24 ft. to 19.24 ft. From ft. to ft.

GRAVEL PACK INTERVALS: From 4.24 ft. to 15.5 ft. From ft. to ft.

6 GROUT MATERIAL:	1 Neat cement	2 Cement grout	3 Bentonite	4 Other
-------------------	---------------	----------------	-------------	---------

Grout Intervals: From #2 0 ft. to 2 ft. From #3 2.0 ft. to 4.24 ft. From ft. to ft.

What is the nearest source of possible contamination:

- | | | | | |
|--------------------------|-----------------|-----------------|------------------------|--------------------------|
| 1 Septic tank | 4 Lateral lines | 7 Pit privy | 10 Livestock pens | 14 Abandoned water well |
| 2 Sewer lines | 5 Cess pool | 8 Sewage lagoon | 11 Fuel storage | 15 Oil well/Gas well |
| 3 Watertight sewer lines | 6 Seepage pit | 9 Feedyard | 12 Fertilizer storage | 16 Other (specify below) |
| | | | 13 Insecticide storage | |

Direction from well? WEST How many feet? 110 ft.

FROM	TO	LITHOLOGIC LOG	FROM	TO	PLUGGING INTERVALS
0.0	0.2	ASPHALT			
0.2	0.6	CONCRETE			
0.6	0.8	GRAVEL			
0.8	5.0	LEAN CLAY dark gray with gravel becoming green discolored with silty clay			
5.0	12.5	LEAN TO FAT CLAY, red brown			
12.5	15.5	FAT CLAY, red brown			
		BOTTOM OF BORING 15.5 feet			

7 CONTRACTOR'S OR LANDOWNER'S CERTIFICATION: This water well was (1) constructed, (2) reconstructed, or (3) plugged under my jurisdiction and was completed on (mo/day/year) 5-17-90 and this record is true to the best of my knowledge and belief. Kansas Water Well Contractor's License No. 416 This Water Well Record was completed on (mo/day/yr) 5-30-90 under the business name of TERRACON CONSULTANTS by (signature) [Signature]
--

INSTRUCTIONS: Use typewriter or ball point pen. PLEASE PRESS FIRMLY and PRINT clearly. Please fill in blanks, underline or circle the correct answers. Send top three copies to Kansas Department of Health and Environment, Bureau of Water, Topeka, Kansas 66620-7320. Telephone: 913-296-5545. Send one to WATER WELL OWNER and retain one for your records.