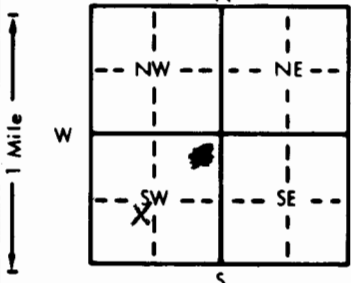


1 LOCATION OF WATER WELL:		Fraction	Section Number	Township Number	Range Number
County: Johnson		NE 1/4 SW 1/4 SW 1/4	4	T 12 S	R 25 E
Distance and direction from nearest town or city street address of well if located within city? On 4700 West 51st Roeland Park, Kansas					
2 WATER WELL OWNER: Amoco Oil Company					
RR#, St. Address, Box #: P.O. Box 419750					
City, State, ZIP Code: Kansas City, Mo. 64141-6750					
Board of Agriculture, Division of Water Resources Application Number:					
3 LOCATE WELL'S LOCATION WITH AN "X" IN SECTION BOX:		4 DEPTH OF COMPLETED WELL: 17' 8" ft. ELEVATION:			
		Depth(s) Groundwater Encountered 1. 16' ft. 2. ft. 3. ft.			
		WELL'S STATIC WATER LEVEL 17 ft. below land surface measured on mo/day/yr 9/29/87			
		Pump test data: Well water was ft. after hours pumping gpm			
		Est. Yield gpm: Well water was ft. after hours pumping gpm			
Bore Hole Diameter 8" in. to ft. and in. to ft.		WELL WATER TO BE USED AS:			
5 Public water supply		8 Air conditioning		11 Injection well	
1 Domestic		3 Feedlot		6 Oil field water supply	
2 Irrigation		4 Industrial		7 Lawn and garden only	
				<u>10 Observation well</u>	
Was a chemical/bacteriological sample submitted to Department? Yes No XX ; If yes, mo/day/yr sample was submitted					
Water Well Disinfected? Yes No XX					
5 TYPE OF BLANK CASING USED:					
1 Steel		3 RMP (SR)		6 Asbestos-Cement	
2 <u>PVC</u>		4 ABS		7 Fiberglass	
Blank casing diameter 2 in. to ft. Dia in. to ft. Dia in. to ft.					
Casing height above land surface 0 in., weight lbs./ft. Wall thickness or gauge No. SCH 40					
TYPE OF SCREEN OR PERFORATION MATERIAL:					
1 Steel		3 Stainless steel		5 Fiberglass	
2 Brass		4 Galvanized steel		6 Concrete tile	
				7 <u>PVC</u>	
				8 RMP (SR)	
				9 ABS	
				10 Asbestos-cement	
				11 Other (specify)	
				12 None used (open hole)	
SCREEN OR PERFORATION OPENINGS ARE:					
1 Continuous slot		3 <u>Mill slot</u>		5 Gauzed wrapped	
2 Louvered shutter		4 Key punched		6 Wire wrapped	
				7 Torch cut	
				8 Saw cut	
				9 Drilled holes	
				10 Other (specify)	
				11 None (open hole)	
SCREEN-PERFORATED INTERVALS: From 7' 8" ft. to 17' 8" ft. From ft. to ft.					
From ft. to ft. From ft. to ft.					
GRAVEL PACK INTERVALS: From 6' ft. to 18' ft. From ft. to ft.					
From ft. to ft. From ft. to ft.					
6 GROUT MATERIAL: 1 Neat cement 2 Cement grout 3 <u>Bentonite</u> 4 Other concrete					
Grout Intervals: From 1' ft. to 6' ft. From ft. to ft. From 0 ft. to 1' ft.					
What is the nearest source of possible contamination:					
1 Septic tank		4 Lateral lines		7 Pit privy	
2 Sewer lines		5 Cess pool		8 Sewage lagoon	
3 Watertight sewer lines		6 Seepage pit		9 Feedyard	
				10 Livestock pens	
				11 <u>Fuel storage</u>	
				12 Fertilizer storage	
				13 Insecticide storage	
				14 Abandoned water well	
				15 Oil well/Gas well	
				16 Other (specify below)	
Direction from well? How many feet? 10' W.					
FROM	TO	LITHOLOGIC LOG	FROM	TO	LITHOLOGIC LOG
0	1	concrete			
1	6	green clay			
6	12	brown silty clay			
12	18	dry brown clay			
18		limestone			
Well owner's ID is #2					
7 CONTRACTOR'S OR LANDOWNER'S CERTIFICATION: This water well was (1) constructed, (2) reconstructed, or (3) plugged under my jurisdiction and was completed on (mo/day/year) 9/29/87 and this record is true to the best of my knowledge and belief. Kansas					
Water Well Contractor's License No. 468 This Water Well Record was completed on (mo/day/yr) 10/2/87					
under the business name of J and R Drilling Services, Inc. by (signature) <i>Raymond Coons</i>					
INSTRUCTIONS: Use typewriter or ball point pen. PLEASE PRESS FIRMLY and PRINT clearly. Please fill in blanks, underline or circle the correct answers. Send top three copies to Kansas Department of Health and Environment, Office of Oil Field and Environmental Geology, Regulation and Permitting Section, Topeka, Kansas 66620-7500, Telephone: 913-862-9360. Send one to WATER WELL OWNER and retain one for your records.					