


1 LOCATION OF WATER WELL:		Fraction	Section Number	Township Number	Range Number
County: <u>Johnson</u>		<u>NW</u> $\frac{1}{4}$ <u>SW</u> $\frac{1}{4}$ <u>NE</u> $\frac{1}{4}$	<u>30</u>	T <u>12</u> S	R <u>25</u> <u>EW</u>

Distance and direction from nearest town or city street address of well if located within city?
8130 Santa Fe Trail Drive, Overland Park, KS

2 WATER WELL OWNER: Texaco Refining & Marketing Inc.

RR#, St. Address, Box # : 14373. Boulder
City, State, ZIP Code : Tulsa, OK 74119

3 LOCATE WELL'S LOCATION WITH AN "X" IN SECTION BOX: 4 DEPTH OF COMPLETED WELL: 14.5 ft. ELEVATION: 96.51

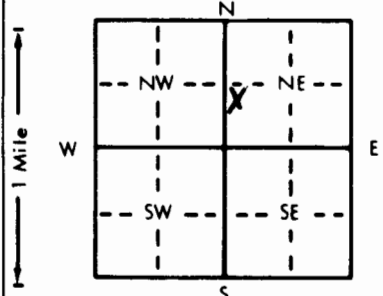

4 DEPTH OF COMPLETED WELL 14.5 ft. ELEVATION: 96.51

Depth(s) Groundwater Encountered 1. 5 ft. 2. ft. 3. ft.
WELL'S STATIC WATER LEVEL 5.48 ft. below land surface measured on mo/day/yr 12/13/90

Pump test data: Well water was ft. after hours pumping gpm

Est. Yield gpm: Well water was ft. after hours pumping gpm

Bore Hole Diameter 14.5 in. to 14.5 ft., and _____ in. to _____ ft.

WELL WATER TO BE USED AS: 5 Public water supply 8 Air conditioning 11 Injection well

1 Domestic	3 Feedlot	6 Oil field water supply	9 Dewatering	12 Other (Specify below)
------------	-----------	--------------------------	--------------	--------------------------

2 Irrigation 4 Industrial 7 Lawn and garden only 10 Monitoring well

Was a chemical/bacteriological sample submitted to Department? Yes.....No.....☒; If yes, mo/day/yr sample was submitted

Water Well Disinfected? Yes.....No.....☒

5	TYPE OF BLANK CASING USED:	5 Wrought iron	8 Concrete tile	CASING JOINTS: Glued	Clamped
---	----------------------------	----------------	-----------------	--------------------------------	-------------------

1 Steel	3 RMP (SR)	6 Asbestos-Cement	9 Other (specify below)	Welded
---------	------------	-------------------	-------------------------	--------------

Blank casing diameter in to ft Dia

Casing height above land surface... Ground Level in., weight lbs./ft. Wall thickness or gauge No. Sch. 40

TYPE OF SCREEN OR PERFORATION MATERIAL: 7 PVC 10 Asbestos-cement

1 Steel	3 Stainless steel	5 Fiberglass	8 RMP (SR)	11 Other (specify)
2 Brass	4 Galvanized steel	6 Concrete tile	9 ABS	12 None used (open hole)

SCREEN OR PERFORATION OPENINGS ARE: 5 Gauzed wrapped 8 Saw cut 11 None (open hole)

1 Continuous slot	3 Mill slot	6 Wire wrapped	9 Drilled holes
-------------------	-------------	----------------	-----------------

2 Louvered shutter 4 Key punched 7 Torch cut 10 Other (specify) _____

SCREEN-PERFORATED INTERVALS: From 5 ft. to 14.5 ft. From _____ ft. to _____ ft.

From ft. to ft. From ft. to ft.

GRAVEL PACK INTERVALS: From 4 ft. to 14.5 ft., From ft. to ft.

		From		ft. to		ft., From		ft. to		ft.	
6	GROUT MATERIAL:	1. Portland cement	2. Cement grout	3. Bentonite	4. Other						

Grout Intervals: From 0 ft. to 1 ft. From 1 ft. to 4 ft. From . ft. to . ft.

What is the nearest source of possible contamination: 10 Livestock pens 14 Abandoned water well

1 Septic tank	4 Lateral lines	7 Pit privy	11 Fuel storage	15 Oil well/Gas well
2 Sewer lines	5 Cess pool	8 Sewage lagoon	12 Fuel/line storage	16 Other (specify below)

2 Sewer lines	5 Cess pool	8 Sewage lagoon	12 Fertilizer storage	Other (specify below)
3 Watertight sewer lines	6 Seepage pit	9 Feedyard	13 Insecticide storage	Former UST Basin

Direction from well? Northeast How many feet? ~150

FROM	TO	LITHOLOGIC LOG	FROM	TO	PLUGGING INTERVALS
0	14.5'	Unconsolidated silty clay			

⑤	1/25	Varicolored Silty Clays			
---	------	-------------------------	--	--	--

14.5'	Weathered limestone.		
-------	----------------------	--	--

[illegible][illegible][illegible][illegible]

					Elevation determined with
--	--	--	--	--	---------------------------

11-13 TO 11-17

WELL ID - MW-13 Amount of rocks height variance

			Crown & casing height variance granted by KDFE.
--	--	--	---

					4.10.18 17/12/18
--	--	--	--	--	------------------

7 CONTRACTOR'S OR LANDOWNER'S CERTIFICATION: This water well was (1) constructed, (2) reconstructed, or (3) plugged under my jurisdiction and was

completed on (mo/day/year) 12/18/10 and this record is true to the best of my knowledge and belief. Kansas
Water Well Contractor's license No. 517 This Water Well Record was completed on (mo/day/yr) 11/3/91

under the business name of Groundwater Technology by (signature) Albert Stont

INSTRUCTIONS: Use typewriter or ball point pen. PLEASE PRESS FIRMLY and PRINT clearly. Please fill in blanks, underline or circle the correct answers. Send top three copies to Kansas Department of Health and Environment, Bureau of Water, Topeka, Kansas 66602-3220. Telephone: 913.236.5545. Send one to WATER WELL OWNER and retain one for your records.

of Health and Environment, Bureau of Water, Topeka, Kansas 66620-7320. Telephone: 913-296-3345. Send one to WATER WELL OWNER and retain one for your records.