


1 LOCATION OF WATER WELL: Fraction **SE ¼ NW ¼ SW ¼** Section Number **3** Township Number **T 12 S** Range Number **R 25** **E**W
 County: **Johnson**

Distance and direction from nearest town or city street address of well if located within city?
5400 Mission Drive, Mission Hills, Kansas

2 WATER WELL OWNER: **Mission Hills Country Club**
 RR#, St. Address, Box # : **5400 Mission Drive** Board of Agriculture, Division of Water Resources
 City, State, ZIP Code : **Shawnee Mission, Kansas 66208** Application Number:

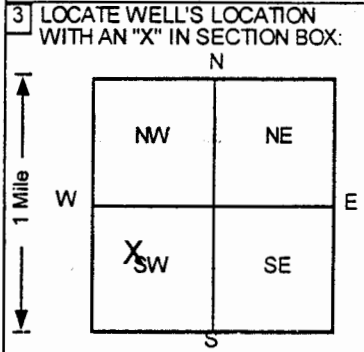

4 DEPTH OF COMPLETED WELL: **15** ft ELEVATION: **899.89**
 Depth(s) Groundwater Encountered 1. **9** ft 2. _____ ft 3. _____ ft
 WELL'S STATIC WATER LEVEL **2.75** ft below land surface measured on mo/day/yr **6/18/97**
 Pump test data: Well water was **NA** ft after _____ hours pumping _____ gpm
 Est. Yield **NA** gpm: Well water was _____ ft after _____ hours pumping _____ gpm
 Bore Hole Diameter **8** in. to **15** ft, and _____ in. to _____ ft
 WELL WATER TO BE USED AS: 5 Public water supply 8 Air conditioning 11 Injection well
 1 Domestic 3 Feedlot 6 Oil field water supply 9 Dewatering 12 Other (Specify below)
 2 Irrigation 4 Industrial 7 Lawn and garden only **10** Monitoring well
 Was a chemical/bacteriological sample submitted to Department? Yes _____ No _____; If yes, mo/day/yr sample was submitted
 Water Well Disinfected? Yes _____ No _____

5 TYPE OF BLANK CASING USED:

1 Steel	3 RMP (SR)	5 Wrought iron	8 Concrete tile	CASING JOINTS: Glued _____ Clamped _____
2 PVC	4 ABS	6 Asbestos-Cement	9 Other (specify below)	Welded _____
		7 Fiberglass		Threaded. <input checked="" type="checkbox"/>

Blank casing diameter **2** in. to **5** ft, Dia. _____ in. to _____ ft, Dia. _____ in. to _____ ft
 Casing height above land surface **-4.68** in., weight **Sch 40** lbs./ft. Wall thickness or gauge No. _____

TYPE OF SCREEN OR PERFORATION MATERIAL

1 Steel	3 Stainless steel	5 Fiberglass	8 RMP (SR)	10 Asbestos-cement
2 Brass	4 Galvanized steel	6 Concrete tile	9 ABS	11 Other (specify) _____
				12 None used (open hole)

SCREEN OR PERFORATION OPENINGS ARE:

1 Continuous slot	3 Mill slot	5 Gauzed wrapped	8 Saw cut	11 None (open hole)
2 Louvered shutter	4 Key punched	6 Wire wrapped	9 Drilled holes	
		7 Torch cut	10 Other (specify) _____	

SCREEN-PERFORATED INTERVALS: From **5** ft to **15** ft, From _____ ft to _____ ft
 From _____ ft to _____ ft, From _____ ft to _____ ft

GRAVEL PACK INTERVALS: From **3** ft to **15** ft, From _____ ft to _____ ft
 From _____ ft to _____ ft, From _____ ft to _____ ft

6 GROUT MATERIAL: 1 Neat cement **2** Cement grout **3** Bentonite 4 Other _____
 Grout intervals: From **0** ft to **1** ft, From **1** ft to **3** ft, From _____ ft to _____ ft

What is the nearest source of possible contamination:

1 Septic tank	4 Lateral lines	7 Pit privy	10 Livestock pens	14 Abandoned water well
2 Sewer lines	5 Cess pool	8 Sewage lagoon	11 Fuel storage	15 Oil well/Gas well
3 Watertight sewer line	6 Seepage pit	9 Feedyard	12 Fertilizer storage	16 Other (specify below)

Former UST Basin
 Direction from well? _____
 How many feet? **0**

FROM	TO	LITHOLOGIC LOG	FROM	TO	PLUGGING INTERVALS
0	9	Clay, Brown			
9	15	Sand, Gray			
					MW1, Tag # 00180524, Flushmount
					Project Name: Mission Hills Country Club
					GeoCore # 470, KDHE # U4 046 933

7 CONTRACTOR'S OR LANDOWNER'S CERTIFICATION: This water well was **1** constructed, (2) reconstructed, or (3) plugged under my jurisdiction and was completed on (mo/day/year) **4/7/97** and this record is true to the best of my knowledge and belief.
 Kansas Water Well Contractor's License No. **527**. This Water Well Record was completed on (mo/day/yr) **6/20/97** under the business name of **GeoCore Services, Inc.** by (signature) *John Roll*