

1 LOCATION OF WATER WELL:	Fraction	Section Number	Township Number	Range Number
County: Johnson	SE ¼ NW ¼ SW ¼	3	T 12 S	R 25 E

Distance and direction from nearest town or city street address of well if located within city?

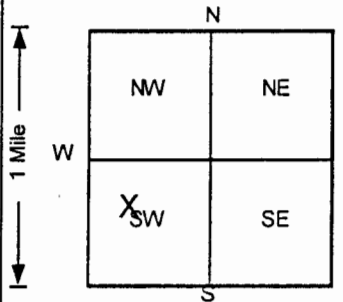
5400 Mission Drive, Mission, Kansas2 WATER WELL OWNER: **Mission Hills Country Club**RR#, St. Address, Box # : **5400 Mission Drive**

Board of Agriculture, Division of Water Resources

City, State, ZIP Code : **Shawnee Mission, Kansas 66208**

Application Number:

3 LOCATE WELL'S LOCATION WITH AN "X" IN SECTION BOX:

4 DEPTH OF COMPLETED WELL **15** ft ELEVATION: **901.87** ftDepth(s) Groundwater Encountered 1. **10** ft 2. ft 3. ftWELL'S STATIC WATER LEVEL ... **5.32** ... ft below land surface measured on mo/day/yr ... **6/18/97** ...Pump test data: Well water was ... **NA** ... ft after ... hours pumping ... gpmEst. Yield .. **NA** .. gpm: Well water was ... ft after ... hours pumping ... gpmBore Hole Diameter ... **8** ... in. to ... **15** ... ft, and ... in. to ... ft

WELL WATER TO BE USED AS: 5 Public water supply 8 Air conditioning 11 Injection well

1 Domestic 3 Feedlot 6 Oil field water supply 9 Dewatering 12 Other (Specify below)

2 Irrigation 4 Industrial 7 Lawn and garden only **10** Monitoring well

Was a chemical/bacteriological sample submitted to Department? Yes.....No✓.....; If yes, mo/day/yr sample was submitted Water Well Disinfected? Yes No ✓

5 TYPE OF BLANK CASING USED:

1 Steel 3 RMP (SR) 5 Wrought iron 8 Concrete tile CASING JOINTS: Glued Clamped

2 PVC 4 ABS 6 Asbestos-Cement 9 Other (specify below) Welded

7 Fiberglass Threaded. ✓

Blank casing diameter **2** in. to **5** ft, Dia in. to ft, Dia in. to ftCasing height above land surface **-4.56** in., weight **Sch 40** lbs./ft. Wall thickness or gauge No.

TYPE OF SCREEN OR PERFORATION MATERIAL

1 Steel 3 Stainless steel 5 Fiberglass **7** PVC 10 Asbestos-cement

2 Brass 4 Galvanized steel 6 Concrete tile 8 RMP (SR) 11 Other (specify)

12 None used (open hole)

SCREEN OR PERFORATION OPENINGS ARE:

1 Continuous slot **3** Mill slot 5 Gauzed wrapped 8 Saw cut 11 None (open hole)

2 Louvered shutter 4 Key punched 6 Wire wrapped 9 Drilled holes

7 Torch cut 10 Other (specify)

SCREEN-PERFORATED INTERVALS: From **5** ft to **15** ft, From ft to ft

From ft to ft, From ft to ft

GRAVEL PACK INTERVALS: From **4** ft to **15** ft, From ft to ft

From ft to ft, From ft to ft

6 GROUT MATERIAL: 1 Neat cement **2** Cement grout **3** Bentonite 4 OtherGrout intervals: From **0** ft to **2** ft, From **2** ft to **4** ft, From ft to ft

What is the nearest source of possible contamination:

1 Septic tank 4 Lateral lines 7 Pit privy 10 Livestock pens 14 Abandoned water well

2 Sewer lines 5 Cess pool 8 Sewage lagoon 11 Fuel storage 15 Oil well/Gas well

3 Watertight sewer lines 6 Seepage pit 9 Feedyard 12 Fertilizer storage **16** Other (specify below)

Former UST Basin

Direction from well?

FROM TO LITHOLOGIC LOG FROM TO PLUGGING INTERVALS

0 **12** Clay, Brown**12** **15** Clay, Light Brown7 CONTRACTOR'S OR LANDOWNER'S CERTIFICATION: This water well was **1** constructed, (2) reconstructed, or (3) plugged under my jurisdictionand was completed on (mo/day/year) **4/8/97** and this record is true to the best of my knowledge and belief.Kansas Water Well Contractor's License No. **527** This Water Well Record was completed on (mo/day/yr) **6/20/97**under the business name of **GeoCore Services, Inc.** by (signature) *[Signature]*