


OFFICE USE ONLY

4

五

SEC

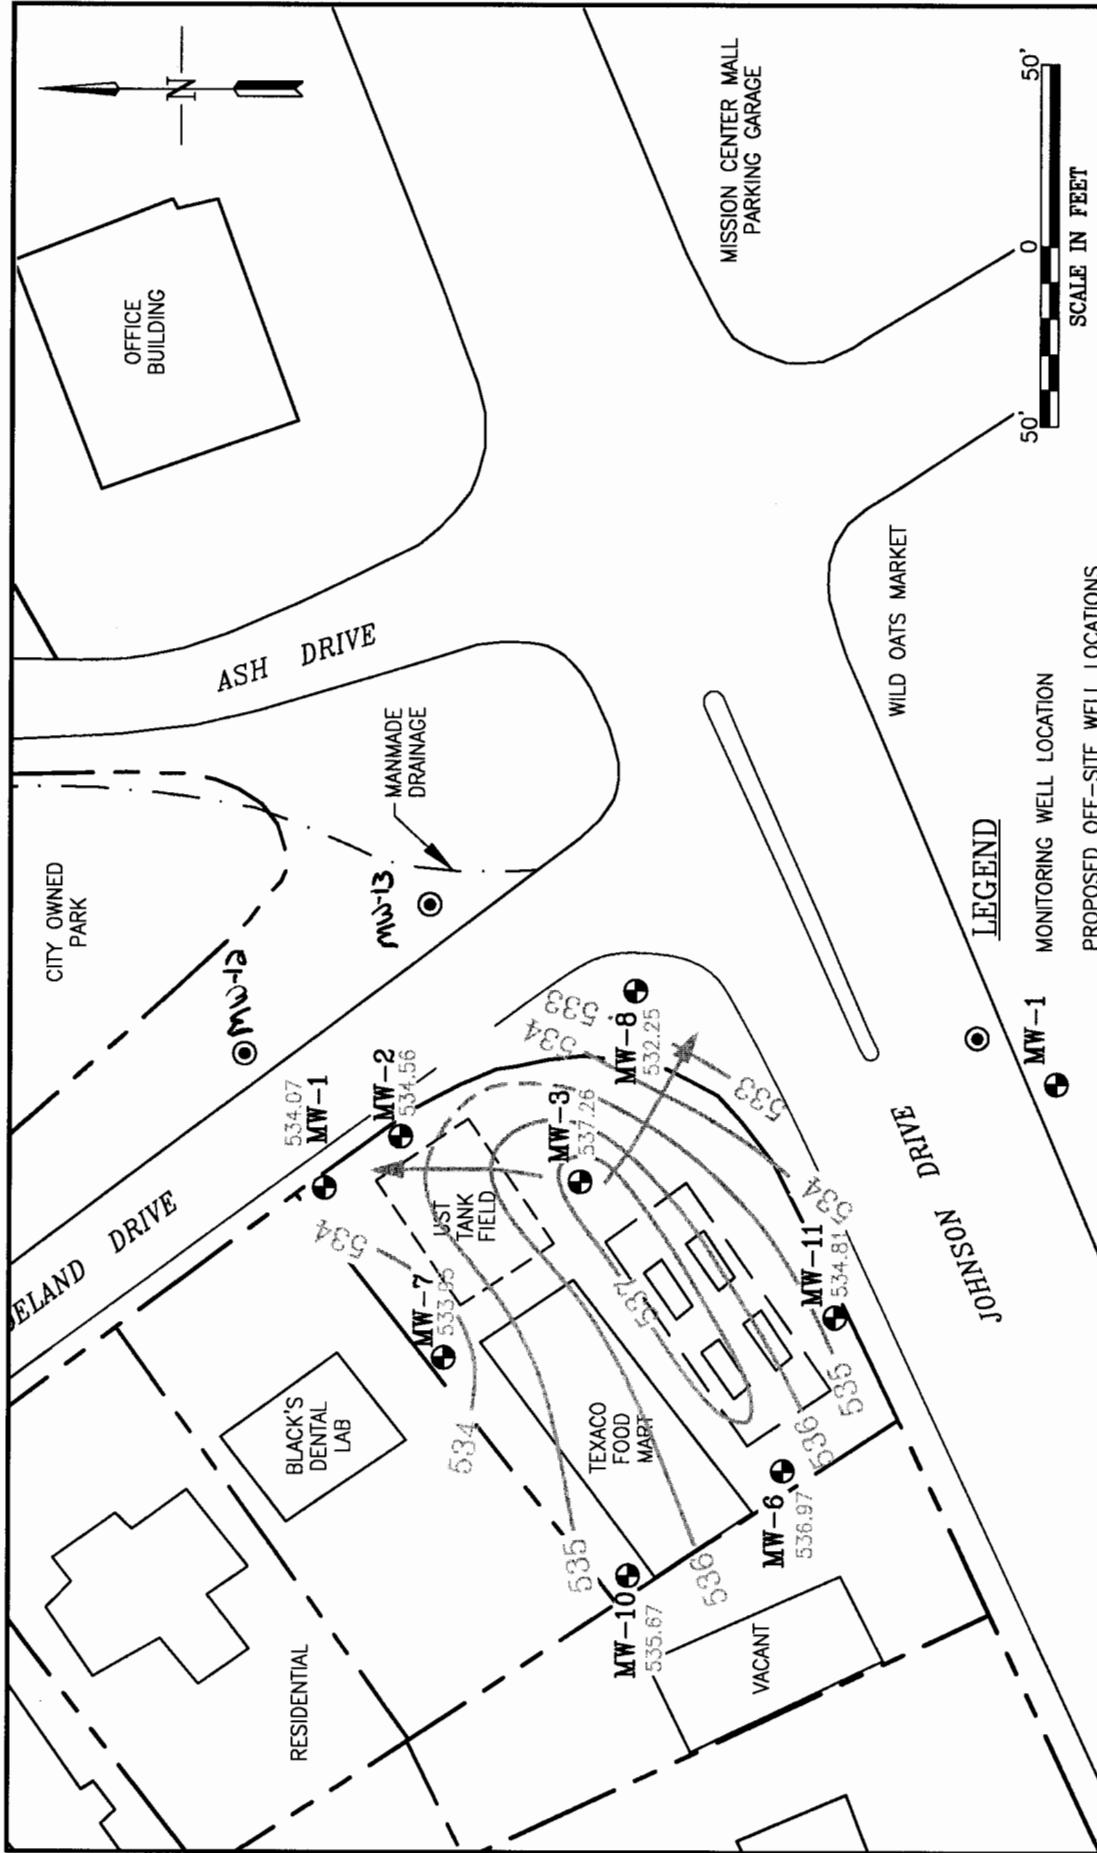

FORMER TEXACO FACILITY
CHEVRON FACILITY NO. 211443
 5100 JOHNSON DRIVE MISSION, KANSAS

GROUNDWATER FLOW MAP
 DECEMBER 8, 2004

drawn	RAM	checked	approved	figure no.
date	01/11/05	date		2
job no.	01-1633-00-7537-070	file no.	7537-002.dwg	

SAIC Science Applications International Corporation
 An Employee-Owned Company

LEGEND

- MONITORING WELL LOCATION
- PROPOSED OFF-SITE WELL LOCATIONS
- GROUNDWATER ELEVATION (FEET)
- GROUNDWATER ELEVATION CONTOURS (DASHED WHERE INFERRED)
- CONTOUR INTERVAL = 1.0 FEET
- INTERPRETED GROUNDWATER FLOW DIRECTION