

CORRECTION(S) TO WATER WELL RECORD (WWC-5)

(to rectify lacking or incorrect information)

County: Johnson

Location listed as:

Section-Township-Range: 9-12 S-22 EFraction ($\frac{1}{4}$ $\frac{1}{4}$ $\frac{1}{4}$): SE SW NW

Location changed to:

9-12 S-25 ESE SW NWOther changes: Initial statements: Wyandotte CountyChanged to: Johnson County

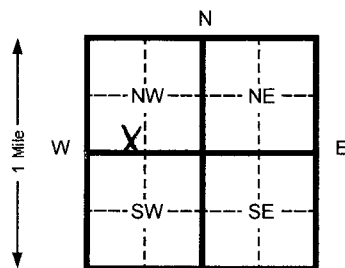
Comments: _____

verification method: written & legal descriptions, city street map,
and Shawnee 1:24,000 topo. map.initials: DRD date: 12/5/2005submitted by: Kansas Geological Survey, Data Resources Library, 1930 Constant Ave., Lawrence, KS 66047-3726
to: Kansas Dept of Health & Environment, Bureau of Water, 1000 SW Jackson, Suite 420, Topeka, KS 66612-1367.

5200 Johnson Drive, Mission, Kansas

Application Number:

4	DEPTH OF COMPLETED WELL	16.8	ft. ELEVATION:
---	-------------------------	------	----------------

Submitted ☐ Water Well Disinfected? Yes ☐ No ☒

How many feet?

[illegible]

By (signature) **Bradley J. Johnson** 

INSTRUCTIONS: Please fill in blanks and circle the correct answers. Send three copies to Kansas Department of Health and Environment, Bureau of Water, Topeka, Kansas 66620-0001. Telephone: 913-296-5545. Send one to WATER WELL OWNER and retain one for your records.